



COUNTER

UPPER CABINET

FULL HEIGHT CABINET

= WASHER/DRYER COMBO
= WASHER
DRYER
= RANGE

= REFRIGERATOR

OCC = OVEN

OCC = DISH WASHER

OCC = TRASH COLLECTOR

3 = WALL HEATER **D** = GAS METER

= ELECTRIC METER CLG = CEILING HEIGHT HH = HEADER HEIGHT

PREPARED FOR

ARCHITECT PLANNING

PRECISION PROPERTY

3626 E. PACIFIC COAST HIGHWAY | 2ND FLOOR

WORRY FREE RENOVATIONS

LONG BEACH CA | 90804

MEASUREMENTS

T 562.621.9100 F 888.698.2966 WWW.PPMCO.NET

PROJECT TYPE

FLOOR PLAN

PROJECT NAME

RESIDENCE

PROJECT ADDRESS

1234 CHERRY TREE BOULEVARD LONG BEACH CITYSCAPE, CA 90000

All plans created by Precision Property
Measurement Ltd "PPM" are made exclusively
for landscaping purposes (Cal. Bus. \$ Prof.
Code §8727). All site plans created by PPM do not
involve the determination of any property line, and as
such do not constitute land surveying
(Cal. Bus. \$ Prof. Code §§8726-8727). In
addition, PPM services and plans do not constitute
civil engineering (Cal. Bus. \$ Prof. Code §§6702-6704),
and thus should not be used for any studies or activities
defined as civil engineering (Cal. Bus. \$ Prof. Code
§6731). All floor plans created by PPM are intended to
be used as a reference for design and construction and
should not be considered a substitute for the services of
a licensed structural engineer or licensed architect. PPM
makes every reasonable effort to ensure the accuracy of
the information found in our plans. However, every
As-Built drawing inherently contains errors to some
degree. It is the duty of the architect, contractor,
designer or other licensed professional, as a consultant
to the property owner, to determine the suitability of the
As-Built plans prior to construction. Measurements should
be field confirmed before commencing construction. In the
event that an error is found on a plan, PPMs liability is
limited to the amount of the fee paid to PPM.





 $\frac{1}{4}$ " = 1'-0" PROJECT

12345 APPROVED BY CT

> DATE 9/18/19

SHEET 4 of 17

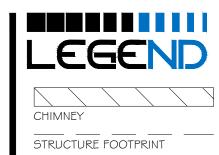

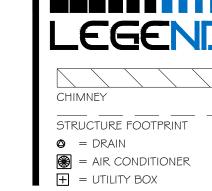



PRECISION PROPERTY **MEASUREMENTS**

3626 E. PACIFIC COAST HIGHWAY | 2ND FLOOR LONG BEACH CA | 90804 T 562.621.9100 F 888.698.2966 WWW.PPMCO.NET



PREPARED FOR

ARCHITECT PLANNING

PROJECT TYPE

ROOF PLAN

PROJECT NAME

RESIDENCE

PROJECT ADDRESS

1234 CHERRY TREE BOULEVARD LONG BEACH, CA 90000

All plans created by Precision Property
Measurement Ltd "PPM" are made exclusively
for landscaping purposes (Cal. Bus. 4 Prof.
Code §8727). All site plans created by PPM do not
involve the determination of any property line, and as
such do not constitute land surveying
(Cal. Bus. 4 Prof. Code §§8726-8727). In
addition, PPM services and plans do not constitute
civil engineering (Cal. Bus. 4 Prof. Code §§6702-6704),
and thus should not be used for any studies or activities
defined as civil engineering (Cal. Bus. 4 Prof. Code
§6731). All floor plans created by PPM are intended to
be used as a reference for design and construction and
should not be considered a substitute for the services of
a licensed structural engineer or licensed architect. PPM
makes every reasonable effort to ensure the accuracy of
the information found in our plans. However, every
As-Built drawing inherently contains errors to some
degree. It is the duty of the architect, contractor,
designer or other licensed professional, as a consultant
to the property owner, to determine the suitability of the
As-Built plans prior to construction. Measurements should
be field confirmed before commencing construction, in the
event that an error is found on a plan, PPM's liability is
limited to the amount of the fee paid to PPM.




 $\frac{1}{4}$ " = 1'-0" PROJECT


12345


APPROVED BY CT DATE

9/18/19 14 of 17

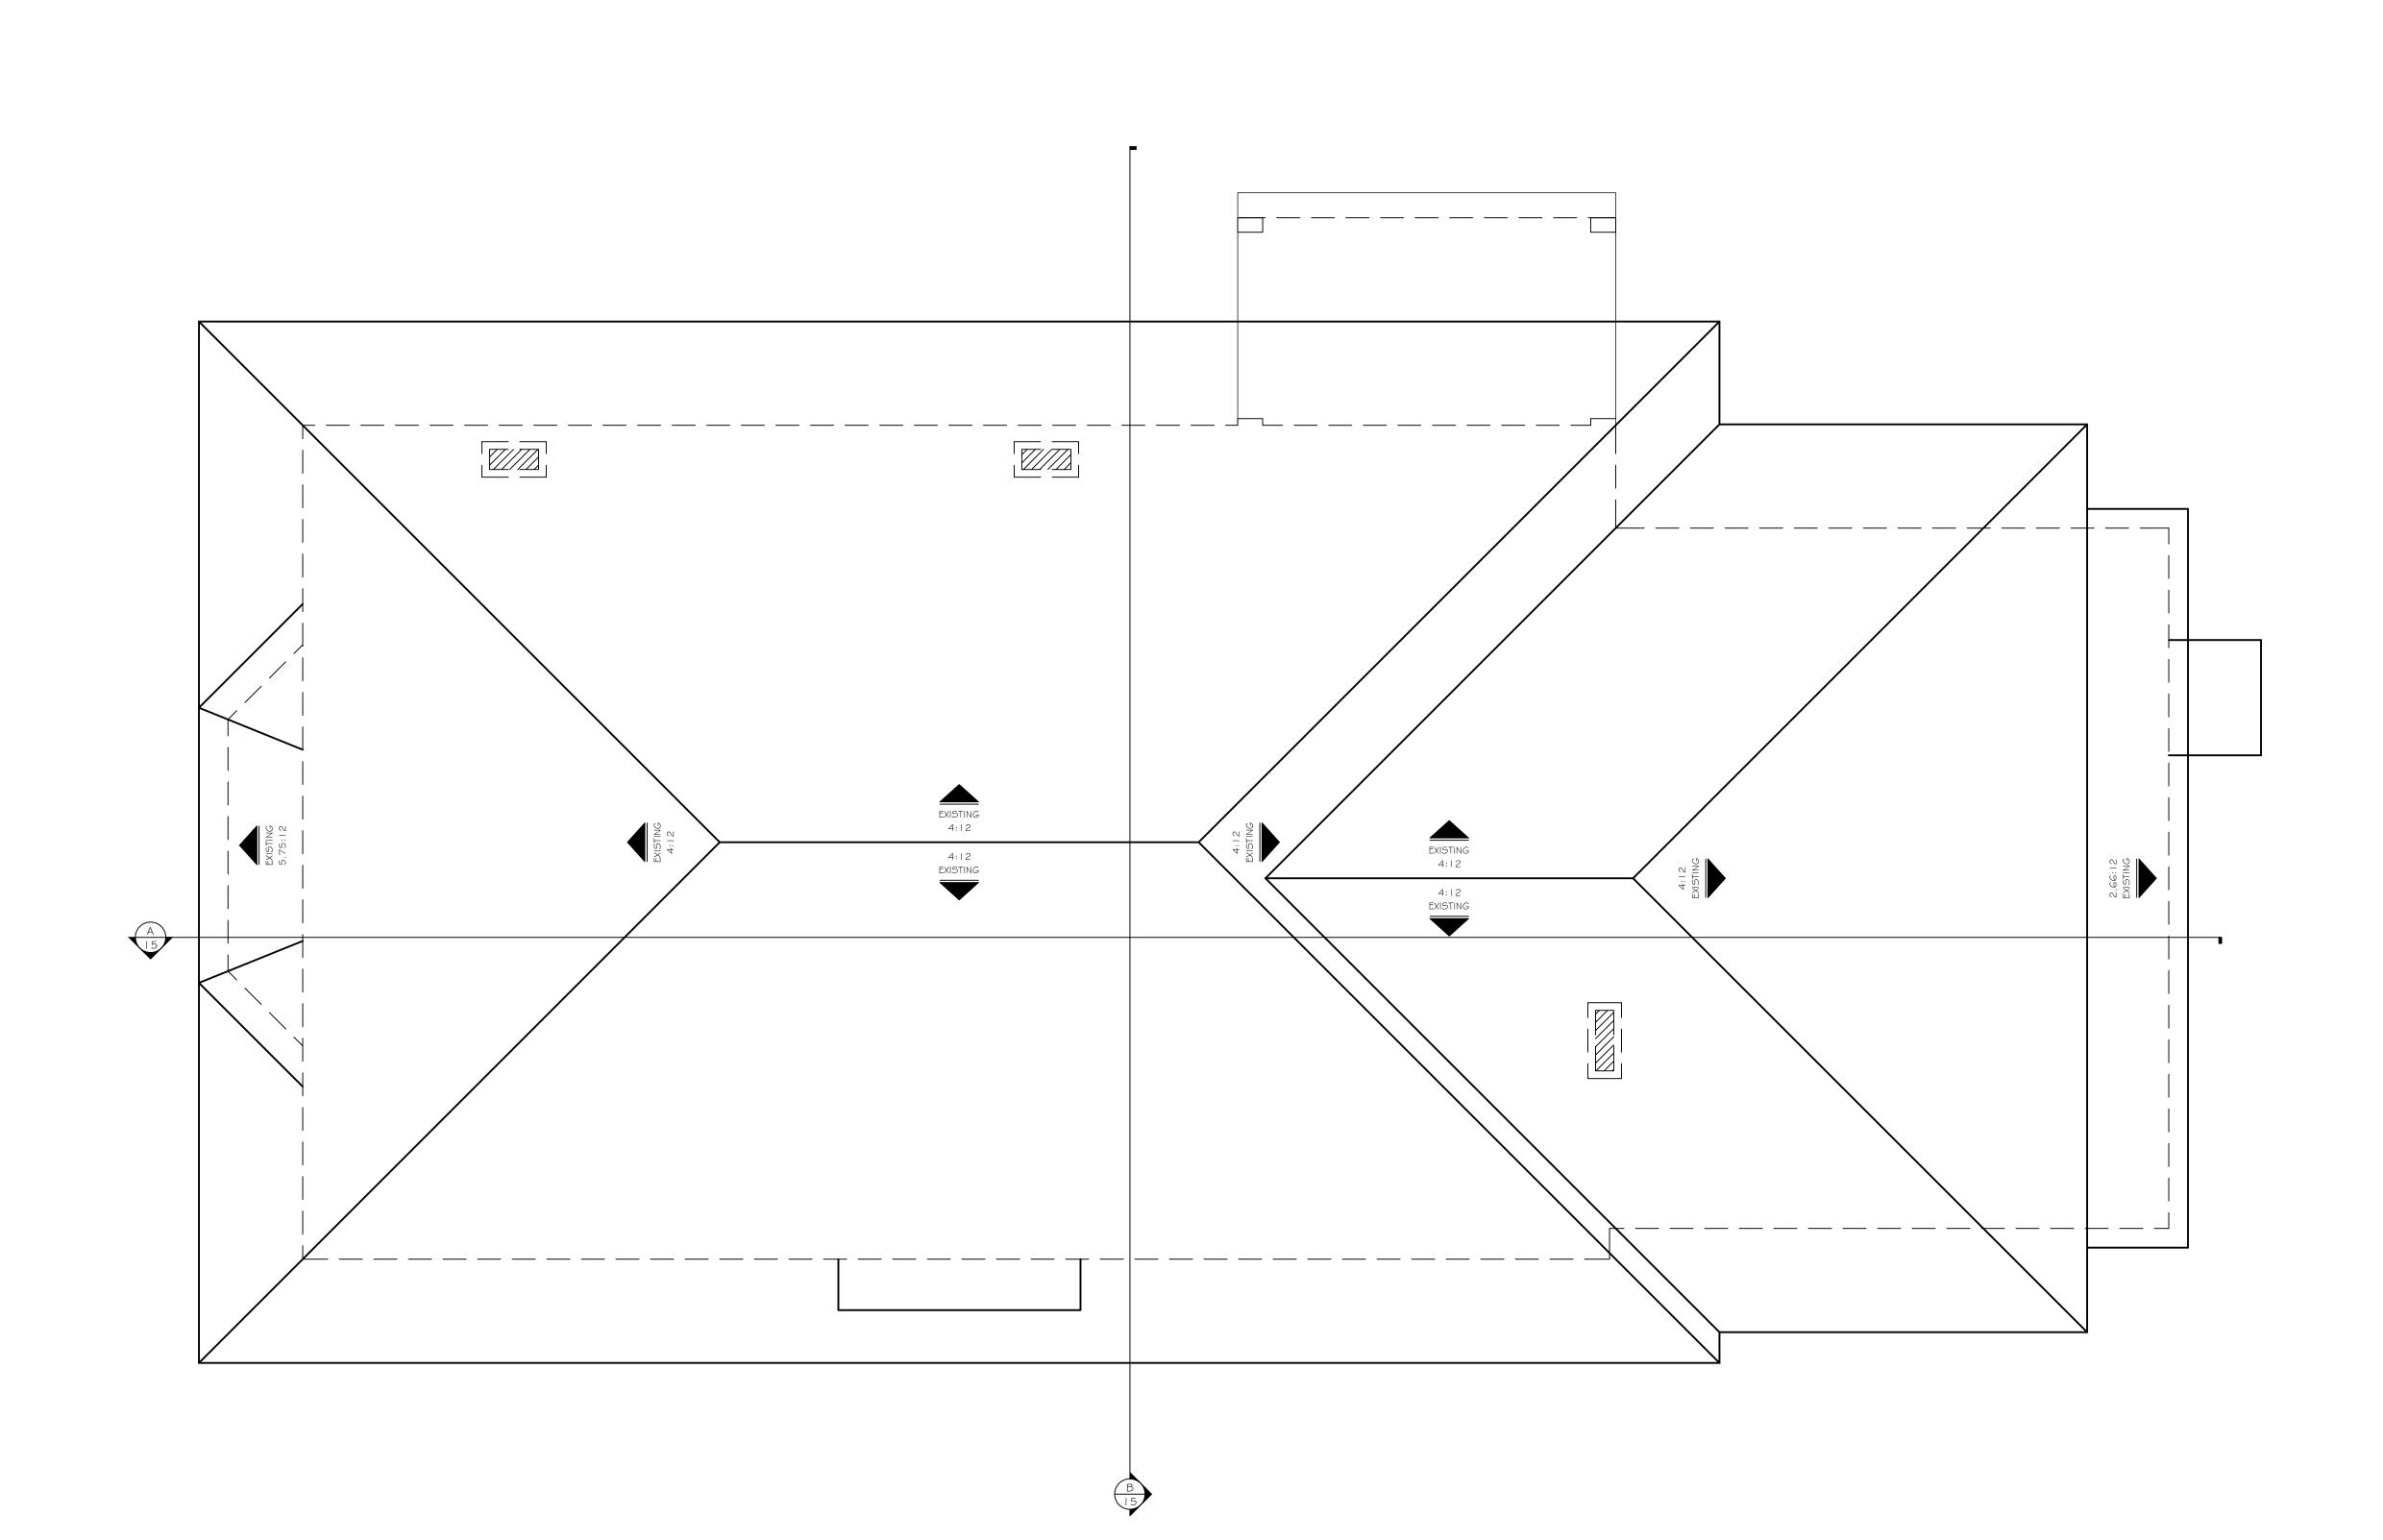



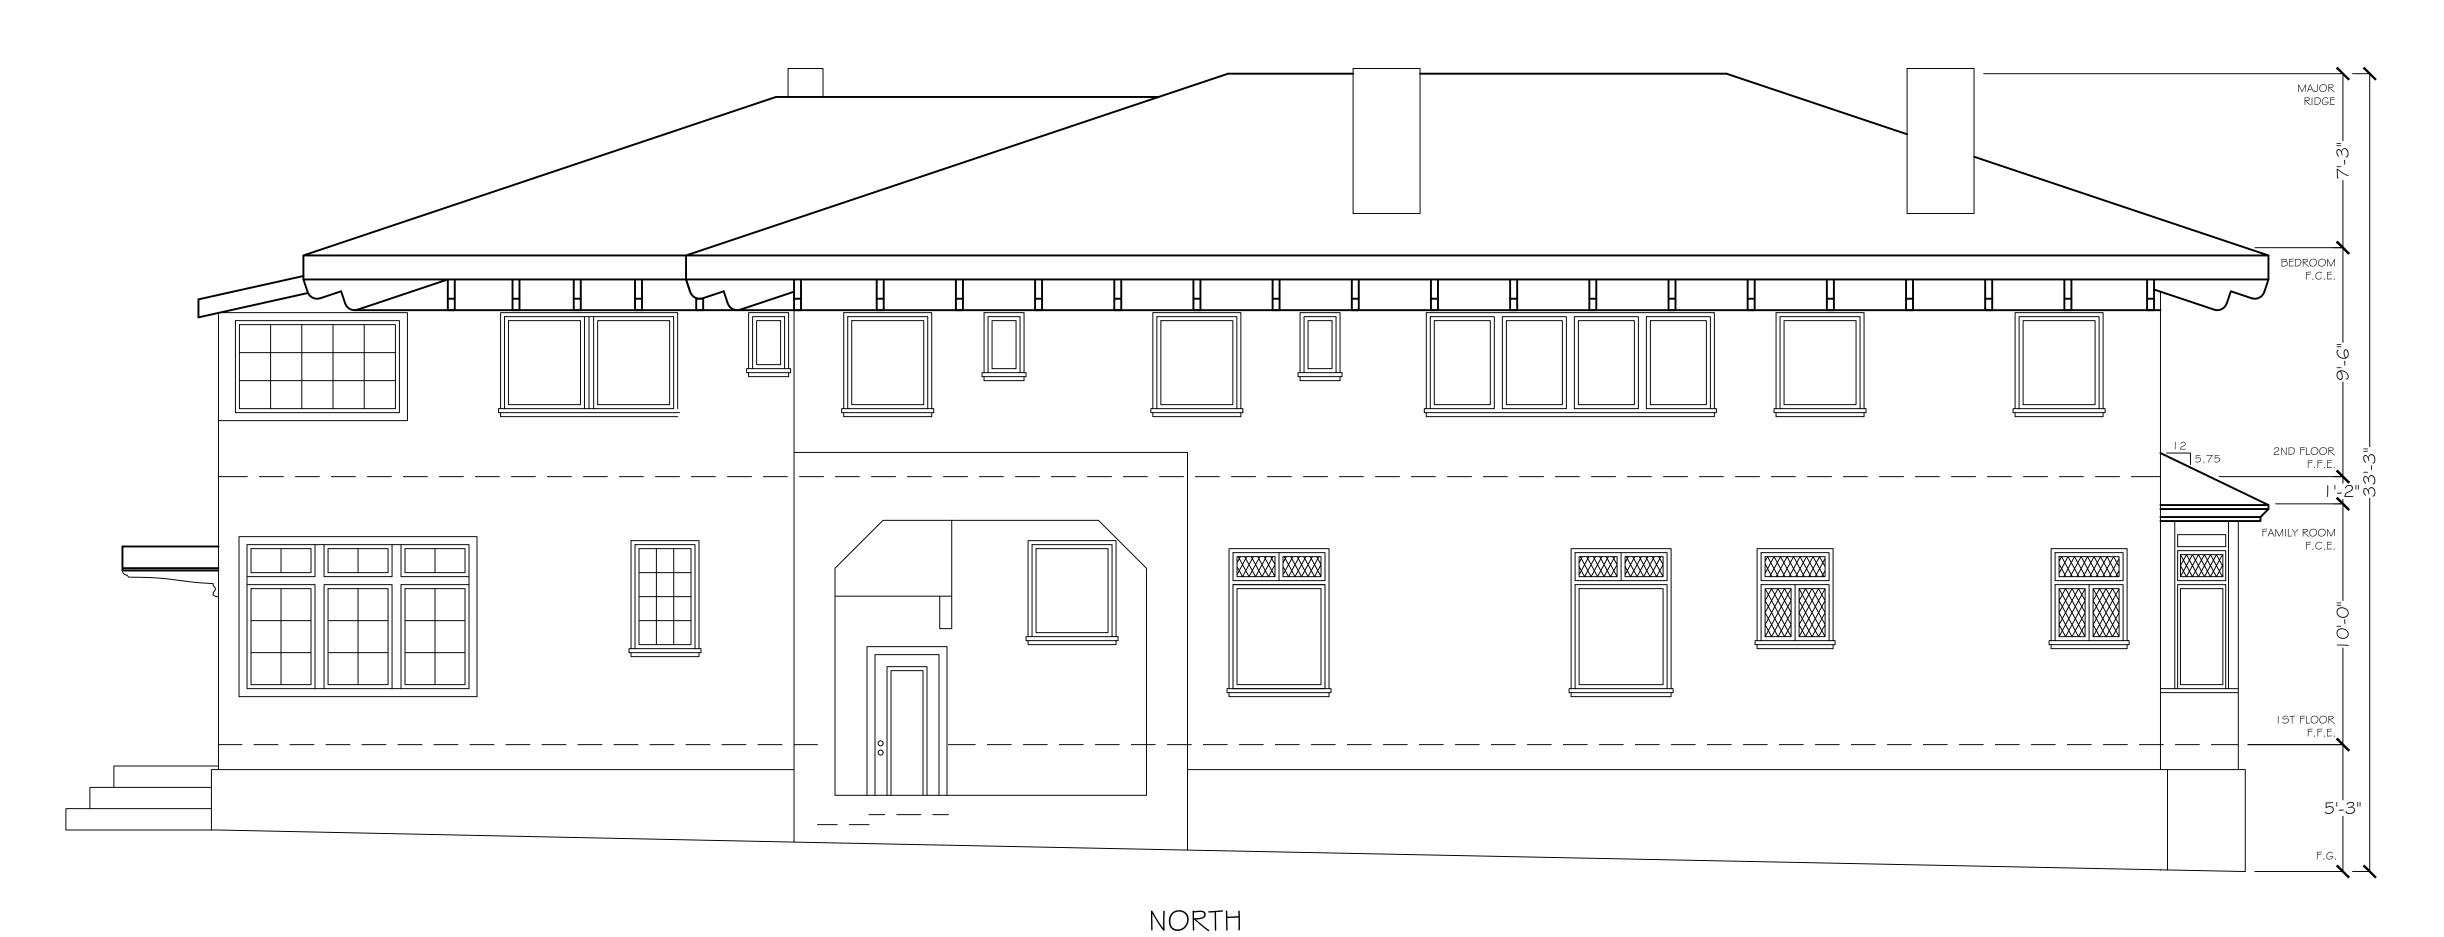

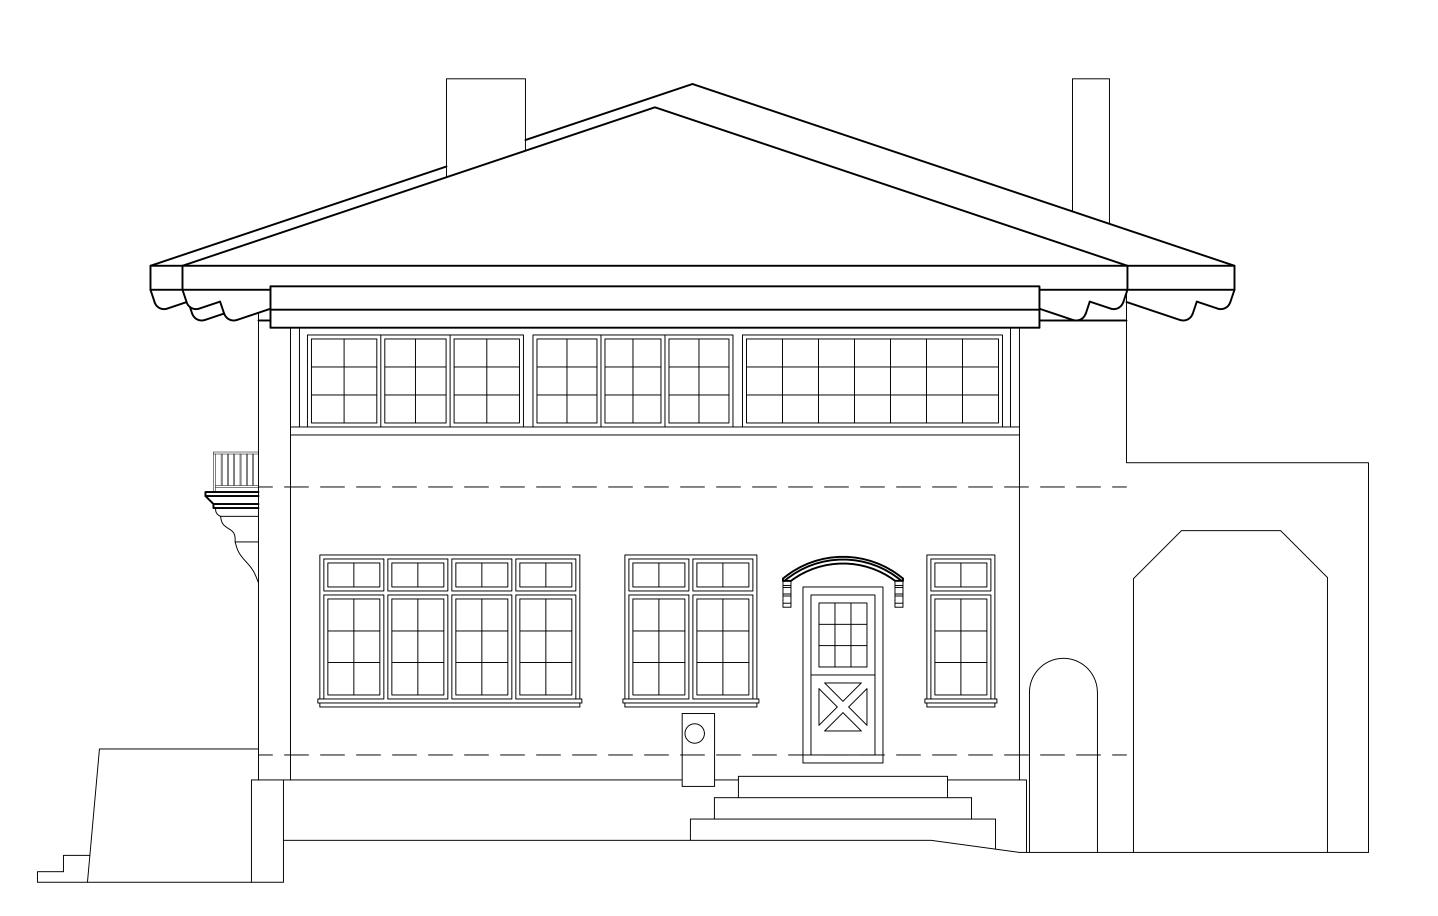

PRECISION PROPERTY **MEASUREMENTS**

3626 E. PACIFIC COAST HIGHWAY | 2ND FLOOR LONG BEACH CA | 90804 T 562.621.9100 F 888.698.2966 WWW.PPMCO.NET



PREPARED FOR

ARCHITECT PLANNING

PROJECT TYPE

EXTERIOR ELEVATIONS

PROJECT NAME

RESIDENCE

PROJECT ADDRESS

1234 CHERRY TREE BOULEVARD LONG BEACH CITYSCAPE, CA 90000

All plans created by Precision Property
Measurement Ltd "PPM" are made exclusively
for landscaping purposes (Cal. Bus. 4 Prof.
Code §8727). All site plans created by PPM do not
involve the determination of any property line, and as
such do not constitute land surveying
(Cal. Bus. 4 Prof. Code §§8726-8727). In
addition, PPM services and plans do not constitute
civil engineering (Cal. Bus. 4 Prof. Code §§6702-6704),
and thus should not be used for any studies or activities
defined as civil engineering (Cal. Bus. 4 Prof. Code
§6731). All floor plans created by PPM are intended to
be used as a reference for design and construction and
should not be considered a substitute for the services of
a licensed structural engineer or licensed architect. PPM
makes every reasonable effort to ensure the accuracy of
the information found in our plans. However, every
As-Built drawing inherently contains errors to some
degree. It is the duty of the architect, contractor,
designer or other licensed professional, as a consultant
to the property owner, to determine the suitability of the
As-Built plans prior to construction. Measurements should
be field confirmed before commencing construction. in the
event that an error is found on a plan, PPM's liability is
limited to the amount of the fee paid to PPM.

 $\frac{1}{4}$ " = 1'-0" PROJECT 12345 APPROVED BY


CT DATE

9/18/19 16 of 17





SOUTH

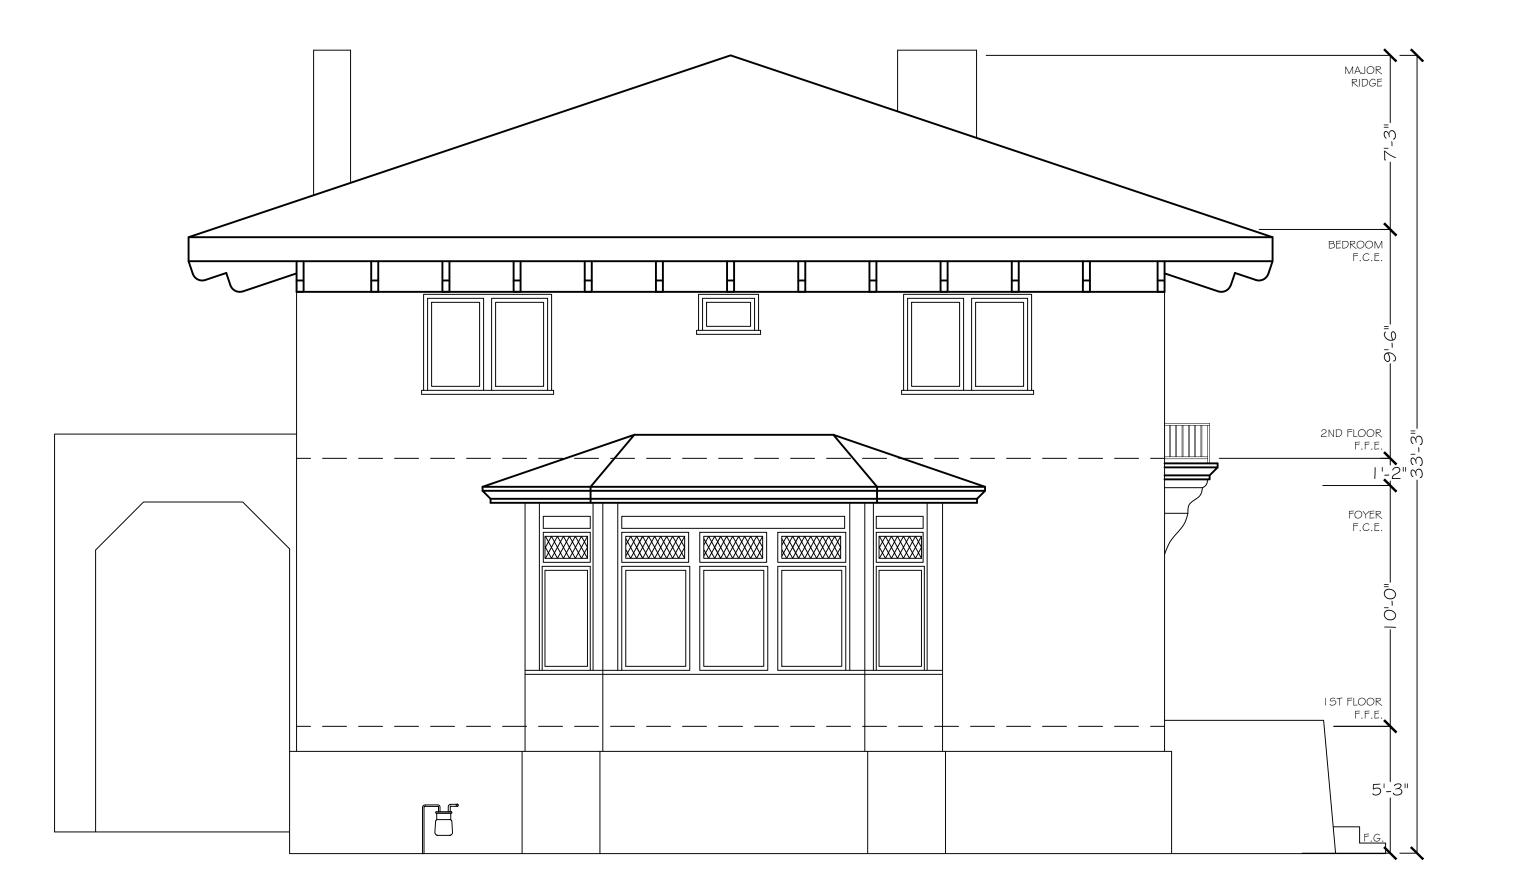

PRECISION PROPERTY

PRECISION PROPE MEASUREMENTS

3626 E. PACIFIC COAST HIGHWAY | 2ND FLOOR LONG BEACH CA | 90804 T 562.621.9100 F 888.698.2966 WWW.PPMCO.NET



PREPARED FOR

ARCHITECT PLANNING

PROJECT TYPE

EXTERIOR ELEVATIONS

PROJECT NAME

SMITH RESIDENCE

PROJECT ADDRESS

I 234 CHERRY TREE BOULEVARD LONG BEACH CITYSCAPE, CA 90000

All plans created by Precision Property
Measurement Ltd "PPM" are made exclusively
for landscaping purposes (Cal. Bus. 4 Prof.
Code §8727). All site plans created by PPM do not
involve the determination of any property line, and as
such do not constitute land surveying
(Cal. Bus. 4 Prof. Code §§8726-8727). In
addition, PPM services and plans do not constitute
civil engineering (Cal. Bus. 4 Prof. Code §§6702-6704),
and thus should not be used for any studies or activities
defined as civil engineering (Cal. Bus. 4 Prof. Code
§6731). All floor plans created by PPM are intended to
be used as a reference for design and construction and
should not be considered a substitute for the services of
a licensed structural engineer or licensed architect. PPM
makes every reasonable effort to ensure the accuracy of
the information found in our plans. However, every
As-Built drawing inherently contains errors to some
degree. It is the duty of the architect, contractor,
designer or other licensed professional, as a consultant
to the property owner, to determine the suitability of the
As-Built plans prior to construction. Measurements should
be field confirmed before commencing construction. in the
event that an error is found on a plan, PPM's liability is
limited to the amount of the fee paid to PPM.

SCALE

1/4" = 1'-0"

PROJECT

1 2345

APPROVED BY

CT

DATE 9/18/19

17 of 17

