



- ↔ = SWITCH
- → = SINGLE OUTLET
- ⇒ = DUPLEX OUTLET

 ⇒ = QUADRUPLEX OUTLET
- **♦** = 220V OUTLET
- ⇒ = FLOOR DUPLEX OUTLET
- =⊗ = SPECIAL PURPOSE OUTLET
 -□ = WALL MOUNT CAMERA
- -⊗ = COVER PLATE ON WALL
- -⊕ = THERMOSTAT -⊕ = AUDIO VOLUME CONTROLS
- SPEAKER WALL
- ☐ = DISCONNECT SWITCH
 ☐ = WALL-MOUNTED FIXTURE
- == FLUORESCENT LIGHT WALL == ELECTRICAL PANEL - FLUSH
- = ELECTRICAL PANEL MOUNTED■ = TELEPHONE JACK
- TELEPHONE JACK— CABLE JACK
- DATA/INTERNET JACK- CABLE TV JACK
- (iii) = EQUIPMENT- MISC.
- -⊕ = POWER POLE -⊕ = BLANK
- -® = AUDIO / VIDEO -® = ROUTER
- -© = SECURITY KEY PAD
- -® = REMOTE DOOR RELEASE
- -⑤ = SENSOR -⑥ = CONDUIT
- $\bigcirc = J-BOX$

PRECISION PROPERTY MEASUREMENTS

WWW.PPMCO.NET

3626 E. PACIFIC COAST HIGHWAY | 2ND FLOOR LONG BEACH CA | 90804 T 562.621.9100 F 888.698.2966



PREPARED FOR

ARCHITECT PLANNING

PROJECT TYPE

ELECTRICAL PLAN

PROJECT NAME

SMITH RESIDENCE

PROJECT ADDRESS

I 234 CHERRY TREE BOULEVARD LONG BEACH, CA 90000

All plans created by Precision Property
Measurement Ltd "PPM" are made exclusively
for landscaping purposes (Cal. Bus. 4 Prof.
Code \$6727). All site plans created by PPM do not
involve the determination of any property line, and as
such do not constitute land surveying
(Cal. Bus. 4 Prof. Code \$58726-8727). In
addition, PPM services and plans do not constitute
civil engineering (Cal. Bus. 4 Prof. Code \$56702-6704),
and thus should not be used for any studies or activities
defined as civil engineering (Cal. Bus. 4 Prof. Code
\$6731). All floor plans created by PPM are intended to
be used as a reference for design and construction and
should not be considered a substitute for the services of
a licensed structural engineer or licensed architect. PPM
makes every reasonable effort to ensure the accuracy of
the information found in our plans. However, every
As-Built drawing inherently contains errors to some
degree. It is the duty of the architect, contractor,
designer or other licensed professional, as a consultant
to the property owner, to determine the suitability of the
As-Built plans prior to construction. Measurements should
be field confirmed before commencing construction. in the
event that an error is found on a plan, PPMS liability is



SCALE
/4" = | '-0"


PROJECT 1 2345

> APPROVED BY CT

> > DATE

9/18/19 SHEET

7 of 17

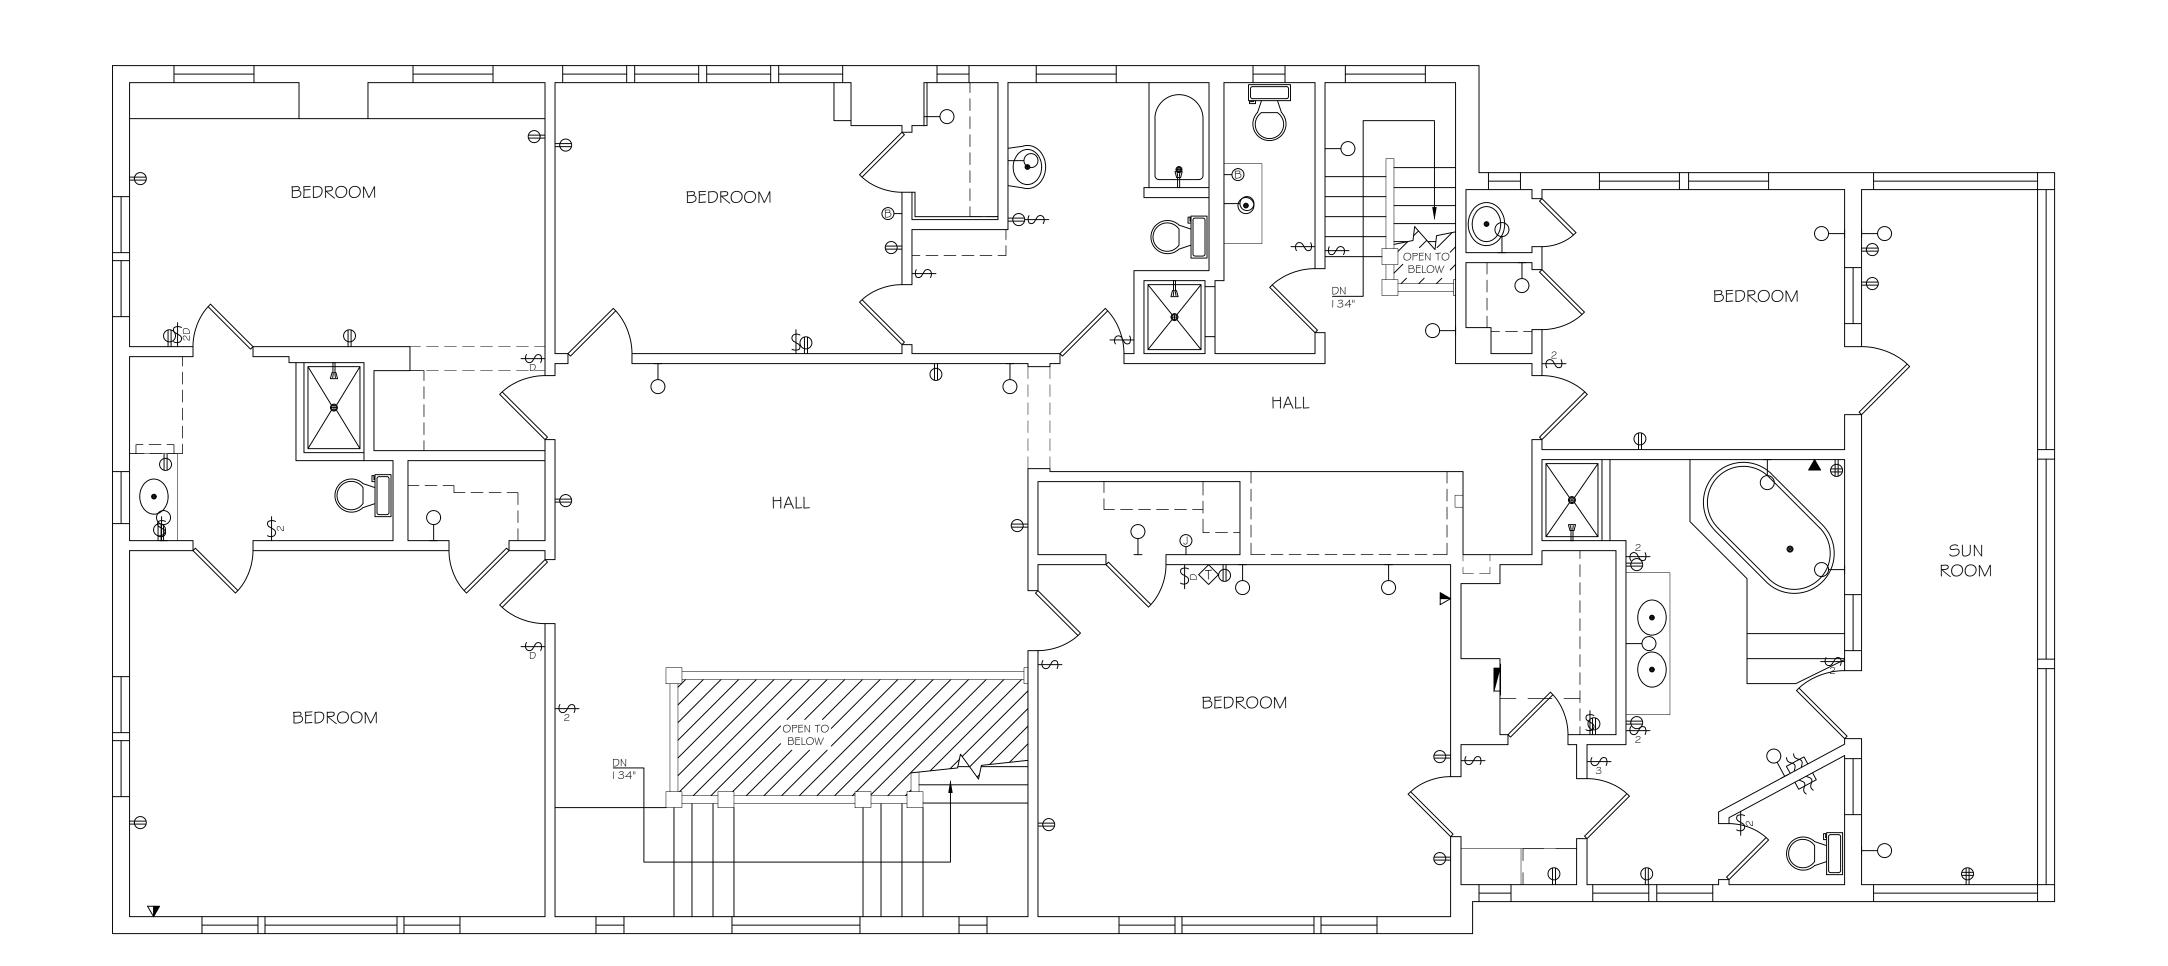

LEGEND

- ↔ = SWITCH
- → = SINGLE OUTLET
- ⇒ = DUPLEX OUTLET

 ⇒ = QUADRUPLEX OUTLET
- **♦** = 220V OUTLET
- = FLOOR DUPLEX OUTLET
- = SPECIAL PURPOSE OUTLET
 -□ = WALL MOUNT CAMERA
- -⊗ = COVER PLATE ON WALL
- -⊕ = THERMOSTAT
 -⊕ = AUDIO VOLUME CONTROLS
- → = WALL-MOUNTED FIXTURE

 == FLUORESCENT LIGHT WALL
- = ELECTRICAL PANEL FLUSH
 = ELECTRICAL PANEL MOUNTED
- = TELEPHONE JACK
- −

 CABLE TV JACK

 = FQUIPMENT- MISC
- EQUIPMENT- MISC.
 POWER POLE
- -⊕ = POWER POLE -⊕ = BLANK
- -⊚ = AUDIO / VIDEO -® = ROUTER
- -© = SECURITY KEY PAD
- -Ø = REMOTE DOOR RELEASE
- -S = SENSOR
- -**○** = CONDUIT -**○** = J-BOX



PRECISION PROPERTY

MEASUREMENTS

3626 E. PACIFIC COAST

HIGHWAY | 2ND FLOOR
LONG BEACH CA | 90804
T 562.621.9100
F 888.698.2966
WWW.PPMCO.NET



PREPARED FOR

ARCHITECT PLANNING

PROJECT TYPE

ELECTRICAL PLAN

PROJECT NAME

SMITH RESIDENCE

PROJECT ADDRESS

I 234 CHERRY TREE BOULEVARD LONG BEACH, CA 90000

All plans created by Precision Property
Measurement Ltd "PPM" are made exclusively
for landscaping purposes (Cal. Bus. \$ Prof.
Code §6727). All site plans created by PPM do not
involve the determination of any property line, and as
such do not constitute land surveying
(Cal. Bus. \$ Prof. Code §86726-8727). In
addition, PPM services and plans do not constitute
civil engineering (Cal. Bus. \$ Prof. Code §66727-6704),
and thus should not be used for any studies or activities
defined as civil engineering (Cal. Bus. \$ Prof. Code
§6731). All floor plans created by PPM are intended to
be used as a reference for design and construction and
should not be considered a substitute for the services of
a licensed structural engineer or licensed architect. PPM
makes every reasonable effort to ensure the accuracy of
the information found in our plans. However, every
As-Built drawing inherently contains errors to some
degree. It is the duty of the architect, contractor,
designer or other licensed professional, as a consultant
to the property owner, to determine the suitability of the
As-Built plans prior to construction. Measurements should
be field confirmed before commencing construction. in the
event that an error is found on a plan, PPMS liability is



SCALE $\frac{1}{4} = 1' - 0''$ PROJECT


PROJECT 1 2345

APPROVED BY

CT

DATE 9/18/19

8 of 17

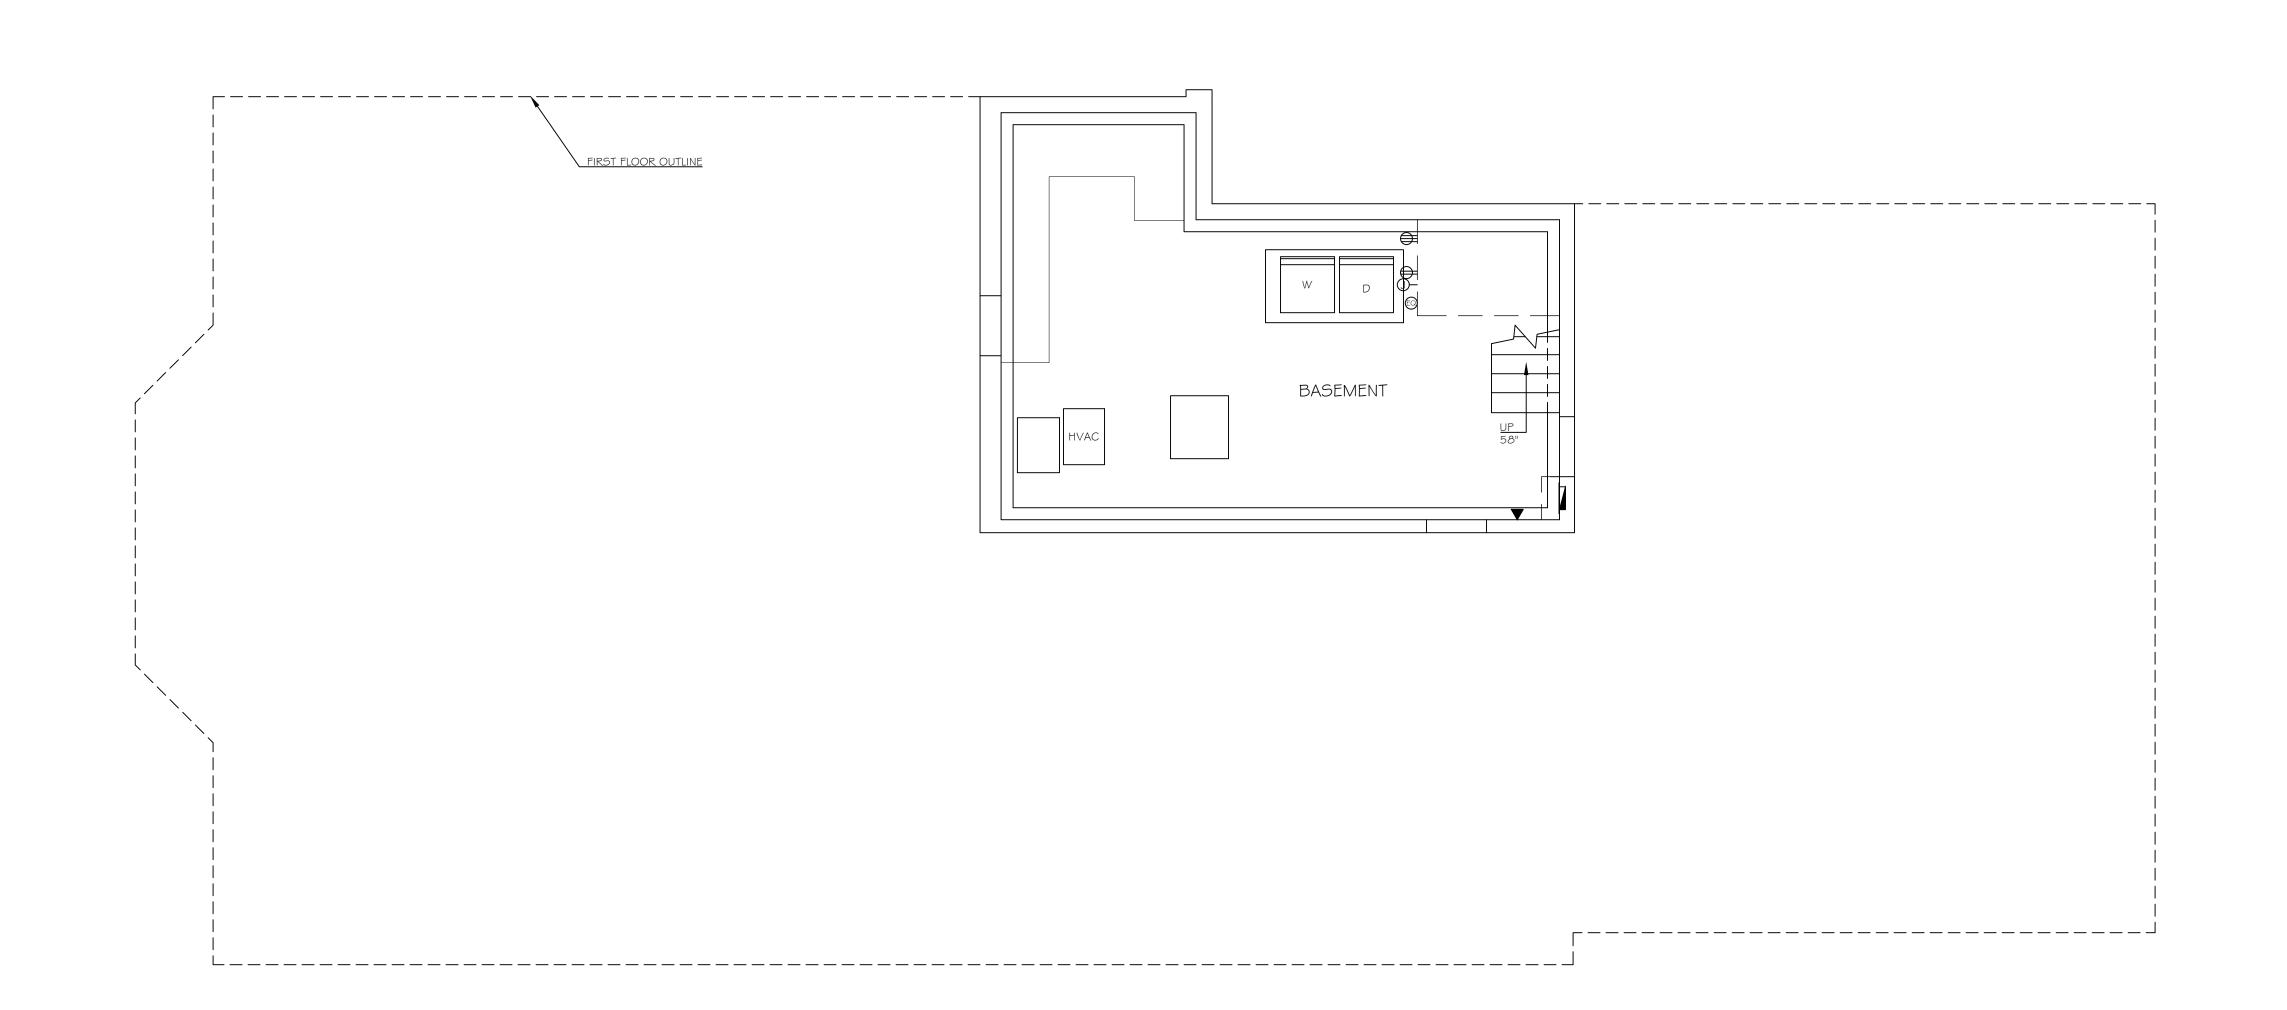

LEGEND

- ← SWITCH \rightarrow = SINGLE OUTLET
- ⇒ = DUPLEX OUTLET
- = QUADRUPLEX OUTLET ⇒ = 220V OUTLET
- 😝 = FLOOR DUPLEX OUTLET
- # = FLOOR QUADRUPLEX OUTLET
- =⊖ = SPECIAL PURPOSE OUTLET -□• = WALL MOUNT CAMERA
- -⊗= COVER PLATE ON WALL
- $-\bigcirc$ = THERMOSTAT -∅ = AUDIO VOLUME CONTROLS
- $-\bigcirc$ = SPEAKER WALL \Box = DISCONNECT SWITCH
- ⊢O = WALL-MOUNTED FIXTURE == FLUORESCENT LIGHT - WALL
- = ELECTRICAL PANEL FLUSH = ELECTRICAL PANEL - MOUNTED
- TELEPHONE JACK
- -<->
 ← CABLE JACK ■ DATA/INTERNET JACK
- -⊚ = CABLE TV JACK
- -⊕ = POWER POLE
- -® = BLANK
- -⊚ = AUDIO / VIDEO $-\otimes$ = ROUTER
- -**⊘** = SECURITY KEY PAD
- -® = REMOTE DOOR RELEASE
- -Ø = SENSOR
- -© = CONDUIT **-**○ = J-BOX

PROJECT TYPE

ELECTRICAL PLAN

PRECISION PROPERTY

3626 E. PACIFIC COAST

LONG BEACH CA | 90804

HIGHWAY | 2ND FLOOR

--------- --------

---- ------

WORRY FREE RENOVATIONS

ARCHITECT

PLANNING

PREPARED FOR


MEASUREMENTS

T 562.621.9100

F 888.698.2966

WWW.PPMCO.NET

- PROJECT NAME
- PROJECT ADDRESS
- 1234 CHERRY TREE BOULEVARD LONG BEACH, CA 90000
- All plans created by Precision Property
 Measurement Ltd "PPM" are made exclusively
 for landscaping purposes (Cal. Bus. 4 Prof.
 Code §8727). All site plans created by PPM do not
 involve the determination of any property line, and as
 such do not constitute land surveying
 (Cal. Bus. 4 Prof. Code §§8726-8727). In
 addition, PPM services and plans do not constitute
 civil engineering (Cal. Bus. 4 Prof. Code §§6702-6704),
 and thus should not be used for any studies or activities
 defined as civil engineering (Cal. Bus. 4 Prof. Code
 §6731). All floor plans created by PPM are intended to
 be used as a reference for design and construction and
 should not be considered a substitute for the services of
 a licensed structural engineer or licensed architect. PPM
 makes every reasonable effort to ensure the accuracy of
 the information found in our plans. However, every
 As-Built drawing inherently contains errors to some
 degree. It is the duty of the architect, contractor,
 designer or other licensed professional, as a consultant
 to the property owner, to determine the suitability of the
 As-Built plans prior to construction. Measurements should
 be field confirmed before commencing construction, in the
 event that an error is found on a plan, PPM's liability is
 limited to the amount of the fee paid to PPM.

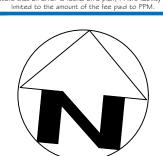

 $\frac{1}{4}$ " = 1'-0"

PROJECT

12345 APPROVED BY CT

DATE 9/18/19

