



PRECISION PROPERTY MEASUREMENTS

3626 E. PACIFIC COAST HIGHWAY | 2ND FLOOR LONG BEACH CA | 90804 T 562.621.9100 F 888.698.2966 WWW.PPMCO.NET



PREPARED FOR

ARCHITECT PLANNING

PROJECT TYPE

ROOF FRAMING


PROJECT NAME

SMITH RESIDENCE

PROJECT ADDRESS

I 234 CHERRY TREE BOULEVARD LONG BEACH, CA 90000

All plans created by Precision Property
Measurement Ltd "PPM" are made exclusively
for landscaping purposes (Cal. Bus. \$ Prof.
Code §6727). All site plans created by PPM do not
involve the determination of any property line, and as
such do not constitute land surveying
(Cal. Bus. \$ Prof. Code §68726-8727). In
addition, PPM services and plans do not constitute
civil engineering (Cal. Bus. \$ Prof. Code §66731). All floor plans created by PPM are intended to
be used as a civil engineering (Cal. Bus. \$ Prof. Code
§6731). All floor plans created by PPM are intended to
be used as a reference for design and construction and
should not be considered a substitute for the services of
a licensed structural engineer or licensed architect. PPM
makes every reasonable effort to ensure the accuracy of
the information found in our plans. However, every
As-Built drawing inherently contains errors to some
degree. It is the duty of the architect, contractor,
designer or other licensed professional, as a consultant
to the property owner, to determine the suitability of the
As-Built plans pror to construction. Measurements should
be field confirmed before commencing construction, in the
event that an error is found on a plan, PPM's liability is
limited to the amount of the fee paid to PPM.

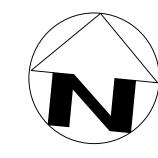


SCALE /4" = 1'-0" PROJECT 1 2345

APPROVED BY


CT

DATE 9/18/19

13 of 17

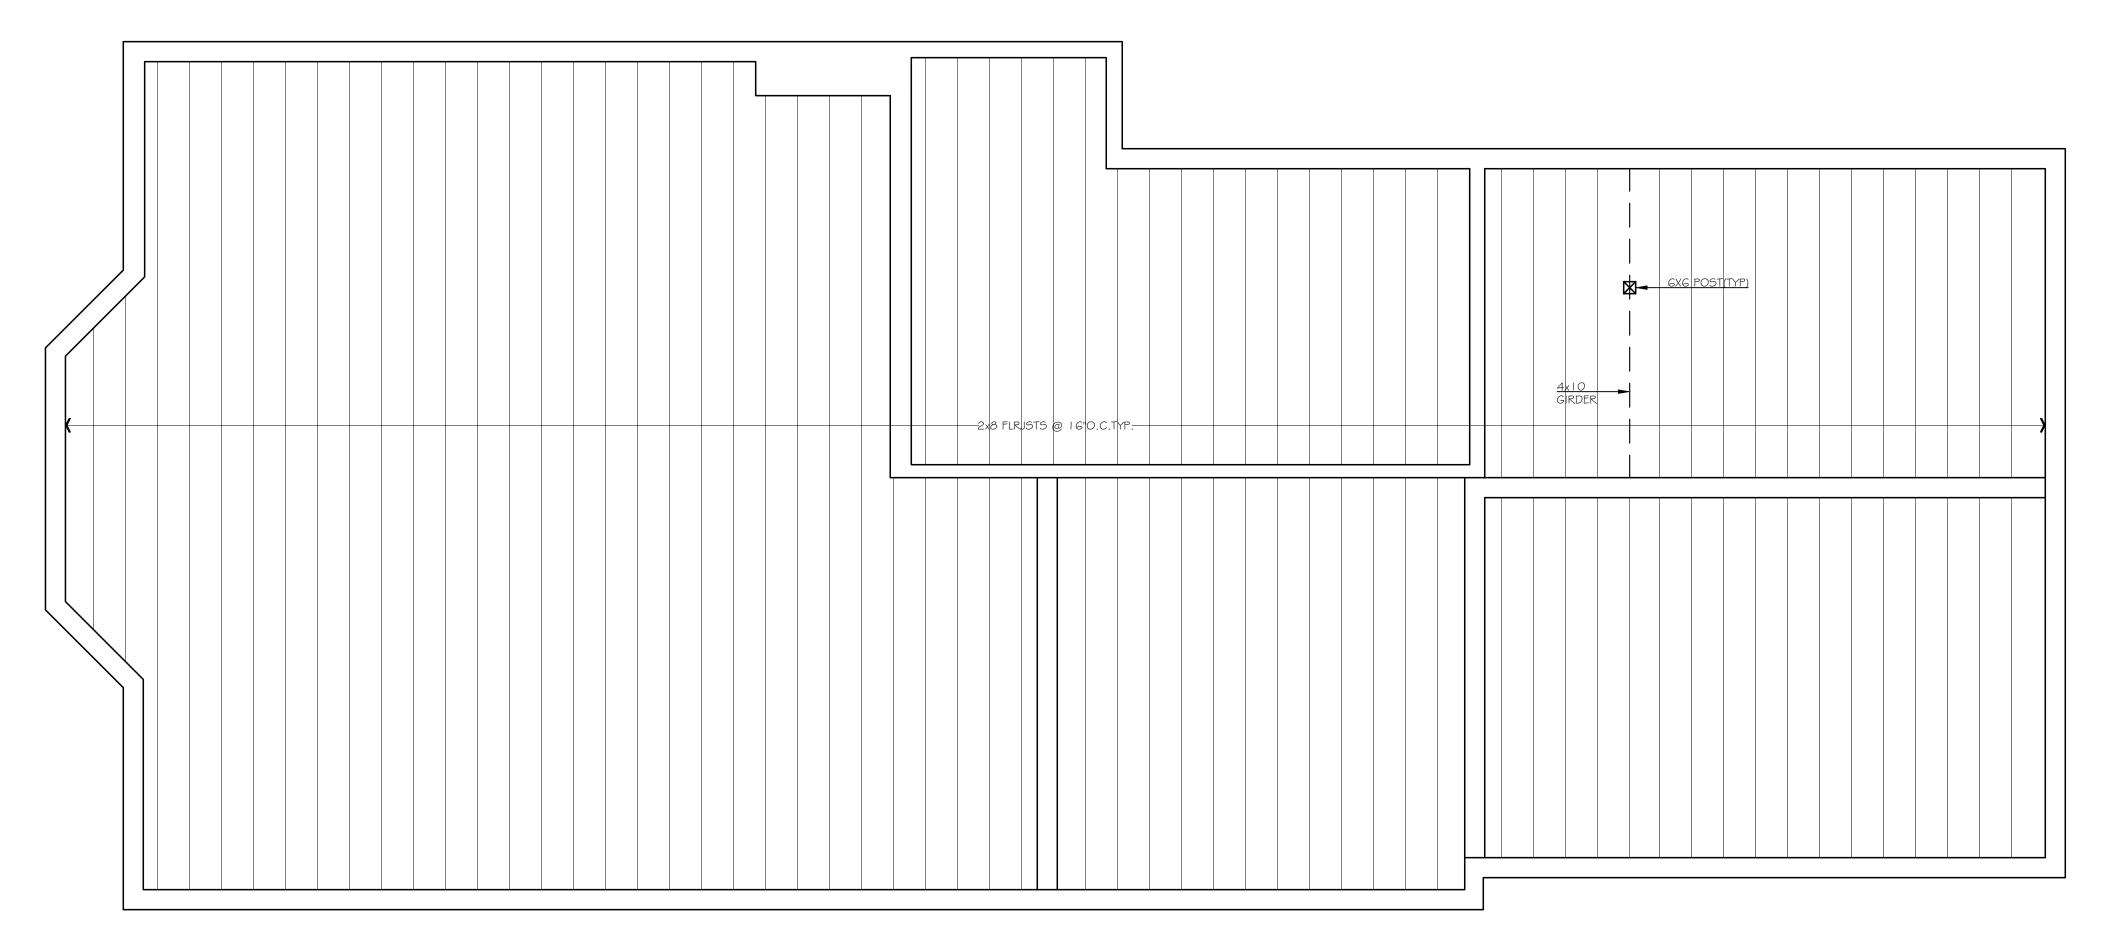

FLOOR FRAMING

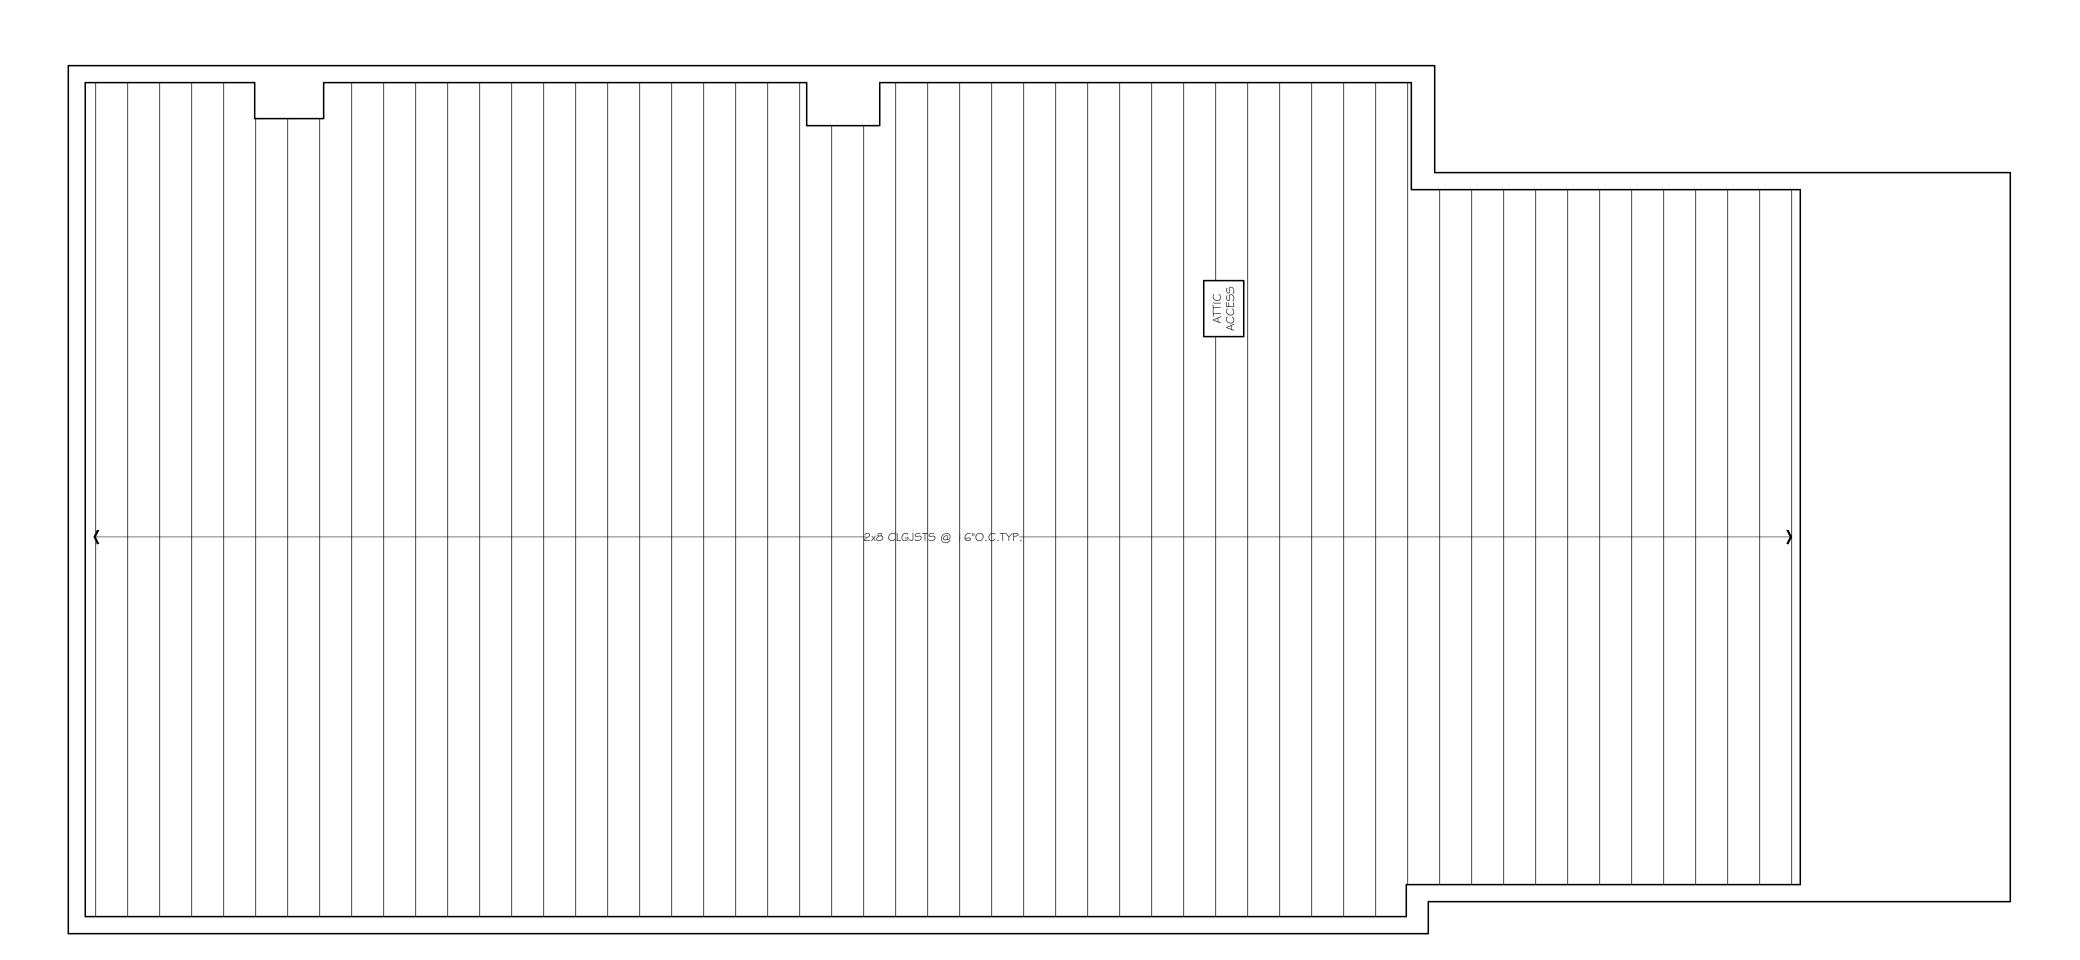

CEILING FRAMING

PPM

PRECISION PROPE MEASUREMENTS

3626 E. PACIFIC COAST
HIGHWAY | 2ND FLOOR
LONG BEACH CA | 90804
T 562.621.9100
F 888.698.2966
WWW.PPMCO.NET



PREPARED FOR

ARCHITECT PLANNING

PROJECT TYPE

FRAMING


PROJECT NAME

SMITH RESIDENCE

PROJECT ADDRESS

I 234 CHERRY TREE BOULEVARD LONG BEACH, CA 90000

All plans created by Precision Property
Measurement Ltd "PPM" are made exclusively
for landscaping purposes (Cal. Bus. & Prof.
Code §8727). All site plans created by PPM do not
involve the determination of any property line, and as
such do not constitute land surveying
(Cal. Bus. & Prof. Code §98726-8727). In
addition, PPM services and plans do not constitute
civil engineering (Cal. Bus. & Prof. Code §96702-6704),
and thus should not be used for any studies or activities
defined as civil engineering (Cal. Bus. & Prof. Code
§6731). All floor plans created by PPM are intended to
be used as a reference for design and construction and
should not be considered a substitute for the services of
a licensed structural engineer or licensed architect. PPM
makes every reasonable effort to ensure the accuracy of
the information found in our plans. However, every
As-Built drawing inherently contains errors to some
degree. It is the duty of the architect, contractor,
designer or other licensed professional, as a consultant
to the property owner, to determine the suitability of the
As-Built plans prior to construction. Measurements should
be field confirmed before commencing construction, in the
event that an error is found on a plan, PPM's liability is
limited to the amount of the fee paid to PPM.

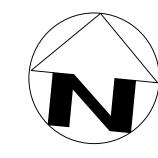

SCALE

/4" = 1'-0"

PROJECT

PROJECT
I 2345
APPROVED BY

CT DATE

9/18/19 SHEET

12 of 17