

- ⚡ = SWITCH
- = SINGLE OUTLET
- ⊖ = DUPLEX OUTLET
- ⊕ = QUADRUPLUX OUTLET
- ⊕⊖ = OUTLET-SWITCH COMBO
- ⊖ = 220V OUTLET
- ⊖ = FLOOR DUPLEX OUTLET
- ⊖ = FLOOR QUADRUPLUX OUTLET
- ⊖ = GFCI DUPLEX OUTLET
- ⊖ = SPECIAL PURPOSE OUTLET
- ⊖ = WALL MOUNTED CAMERA
- ⊖ = WALL COVER PLATE
- ⊖ = THERMOSTAT
- ⊖ = WALL MOUNTED SPEAKER
- ⊖ = DISCONNECT SWITCH
- = WALL MOUNTED FIXTURE
- ⊖ = WALL MOUNTED FLUORESCENT LIGHT
- ⊖ = FLUSH MOUNTED ELECTRICAL PANEL
- ⊖ = MOUNTED ELECTRICAL PANEL
- ⊖ = ELECTRIC METER
- ⊖ = TELEPHONE JACK
- ⊖ = DATA/INTERNET JACK
- ⊖ = CABLE TV JACK
- ⊖ = MISC. EQUIPMENT
- ⊖ = BLANK
- ⊖ = AUDIO/VIDEO
- ⊖ = ROUTER
- ⊖ = SECURITY KEY PAD
- ⊖ = REMOTE DOOR RELEASE
- ⊖ = SENSOR
- ⊖ = CONDUIT
- ⊖ = J-BOX



PREPARED FOR

CLIENT

PROJECT TYPE

**ELECTRICAL PLAN**


PROJECT NAME

**LARGE SFR SAMPLE**

PROJECT ADDRESS

1234 PRECISION BOULEVARD  
 CITY, CA 00000

All plans created by Precision Property Measurements, LLC ("PPM") are made exclusively for the purposes of the project and are not to be used for any other purpose. PPM does not warrant the accuracy or completeness of the information provided in this plan. PPM makes every reasonable effort to ensure the accuracy of the information provided in this plan. However, PPM makes no representation or warranty, in whole or in part, as to the accuracy or completeness of the information provided in this plan. PPM is not responsible for any errors or omissions in this plan. PPM's liability is limited to the amount of the fee paid to PPM.

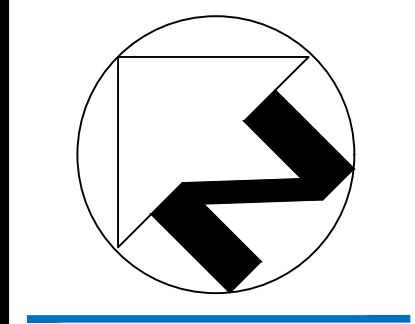



SCALE  
 1/4" = 1'-0"

PROJECT  
 XXXX\_XX

APPROVED BY  
 XX

DATE  
 XX/XX/XX

SHEET  
 6 of 25

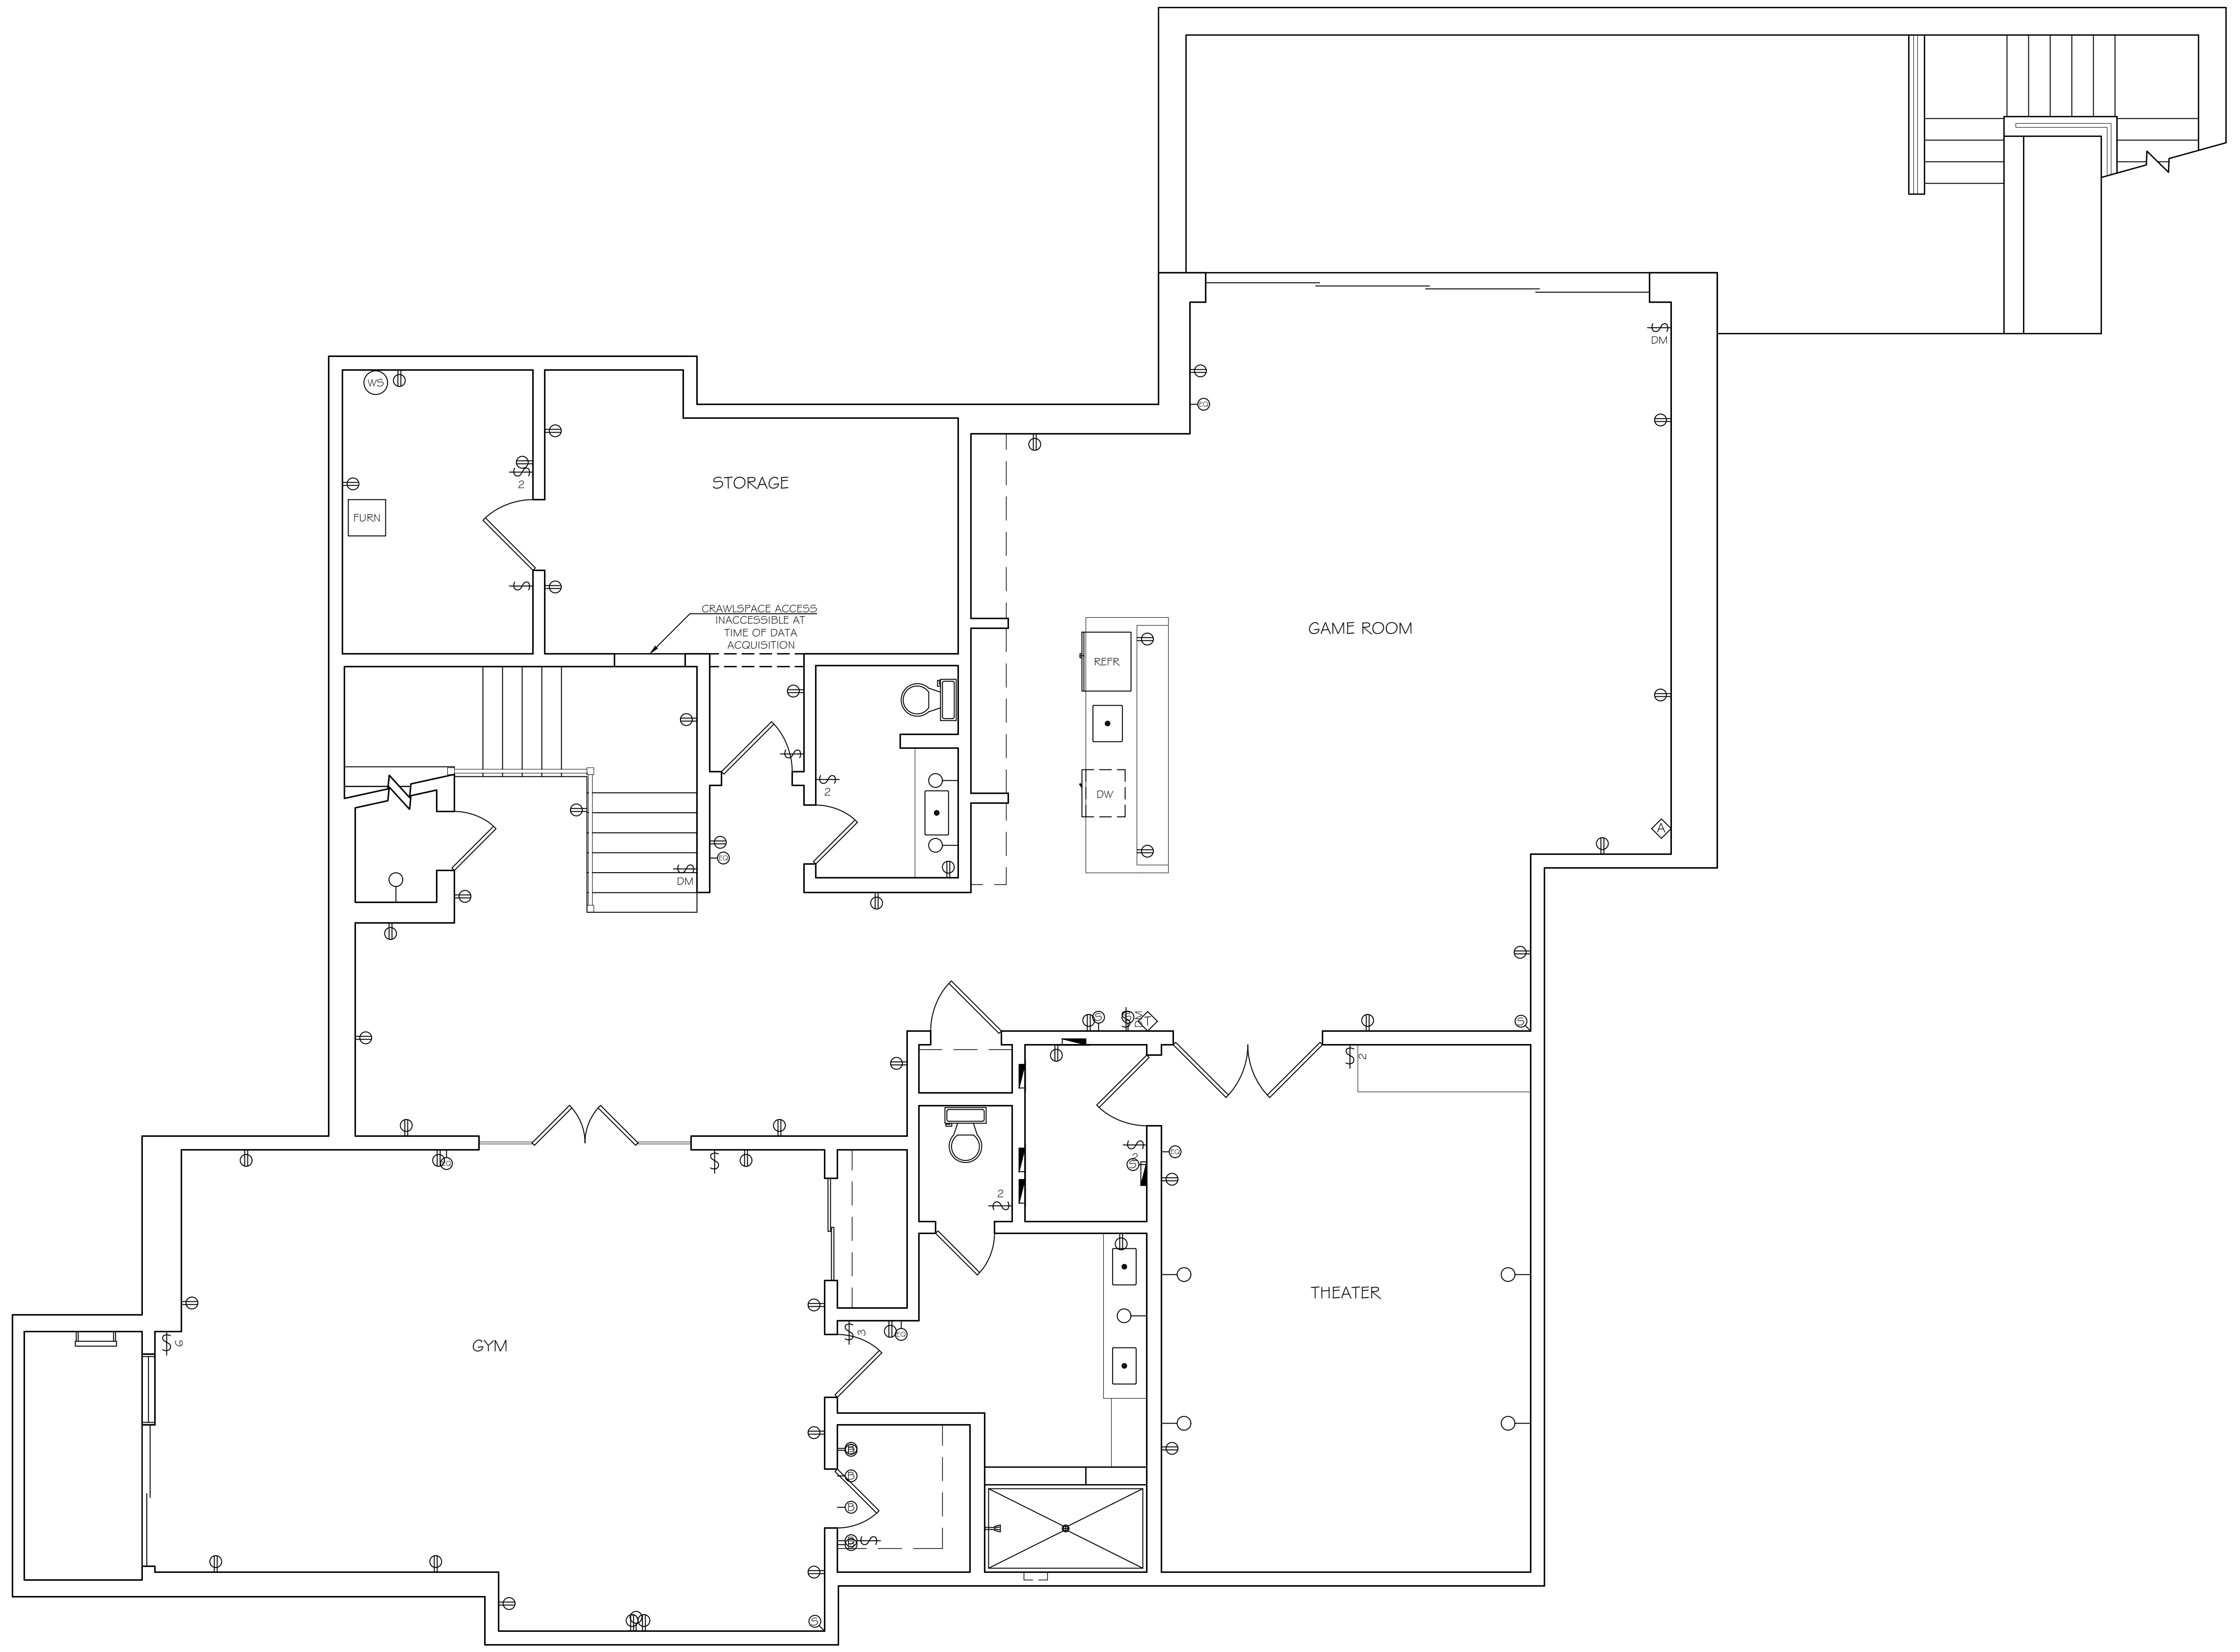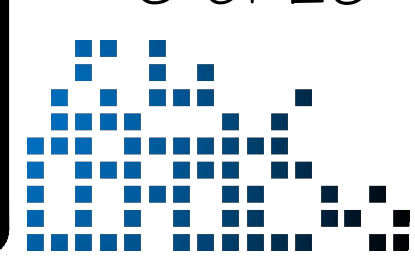

**BASEMENT**

- ⚡ = SWITCH
- = SINGLE OUTLET
- ⊕ = DUPLEX OUTLET
- ⊕⊕ = QUADRUPLUX OUTLET
- ⊕⊕ = OUTLET-SWITCH COMBO
- ⊕ = 220V OUTLET
- ⊕ = FLOOR DUPLEX OUTLET
- ⊕⊕ = FLOOR QUADRUPLUX OUTLET
- ⊕ = GFCI DUPLEX OUTLET
- ⊕ = SPECIAL PURPOSE OUTLET
- 📷 = WALL MOUNTED CAMERA
- ⊗ = WALL COVER PLATE
- ⊖ = THERMOSTAT
- 🔊 = WALL MOUNTED SPEAKER
- ⊖ = DISCONNECT SWITCH
- ⊖ = WALL MOUNTED FIXTURE
- ⊖ = WALL MOUNTED FLUORESCENT LIGHT
- ⊖ = FLUSH MOUNTED ELECTRICAL PANEL
- ⊖ = MOUNTED ELECTRICAL PANEL
- ⊖ = ELECTRIC METER
- 📞 = TELEPHONE JACK
- 🌐 = DATA/INTERNET JACK
- 📺 = CABLE TV JACK
- ⊖ = MISC. EQUIPMENT
- ⊖ = BLANK
- ⊖ = AUDIO/VIDEO
- ⊖ = ROUTER
- ⊖ = SECURITY KEY PAD
- ⊖ = REMOTE DOOR RELEASE
- ⊖ = SENSOR
- ⊖ = CONDUIT
- ⊖ = J-BOX



PREPARED FOR

CLIENT

PROJECT TYPE

**ELECTRICAL PLAN**


PROJECT NAME

**LARGE SFR SAMPLE**

PROJECT ADDRESS

1234 PRECISION BOULEVARD  
 CITY, CA 00000

All plans created by Precision Property Measurements, LLC ("PPM") are made exclusively for the purposes of the project and are not to be used for any other purpose. PPM does not warrant the accuracy or completeness of the information provided on these plans. PPM makes every reasonable effort to ensure the accuracy of the information provided on these plans. However, some errors may occur due to human error or other factors. PPM makes every reasonable effort to ensure the accuracy of the information provided on these plans. However, some errors may occur due to human error or other factors. PPM makes every reasonable effort to ensure the accuracy of the information provided on these plans. However, some errors may occur due to human error or other factors.

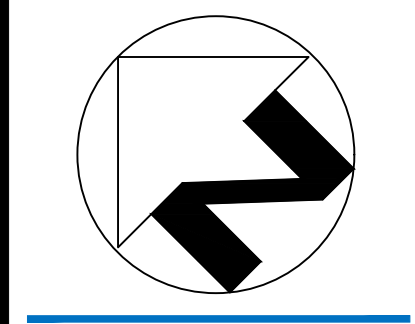


SCALE  
 1/4" = 1'-0"

PROJECT  
 XXXX\_XX

APPROVED BY  
 XX

DATE  
 XXX/XX/XX

SHEET  
 7 of 25

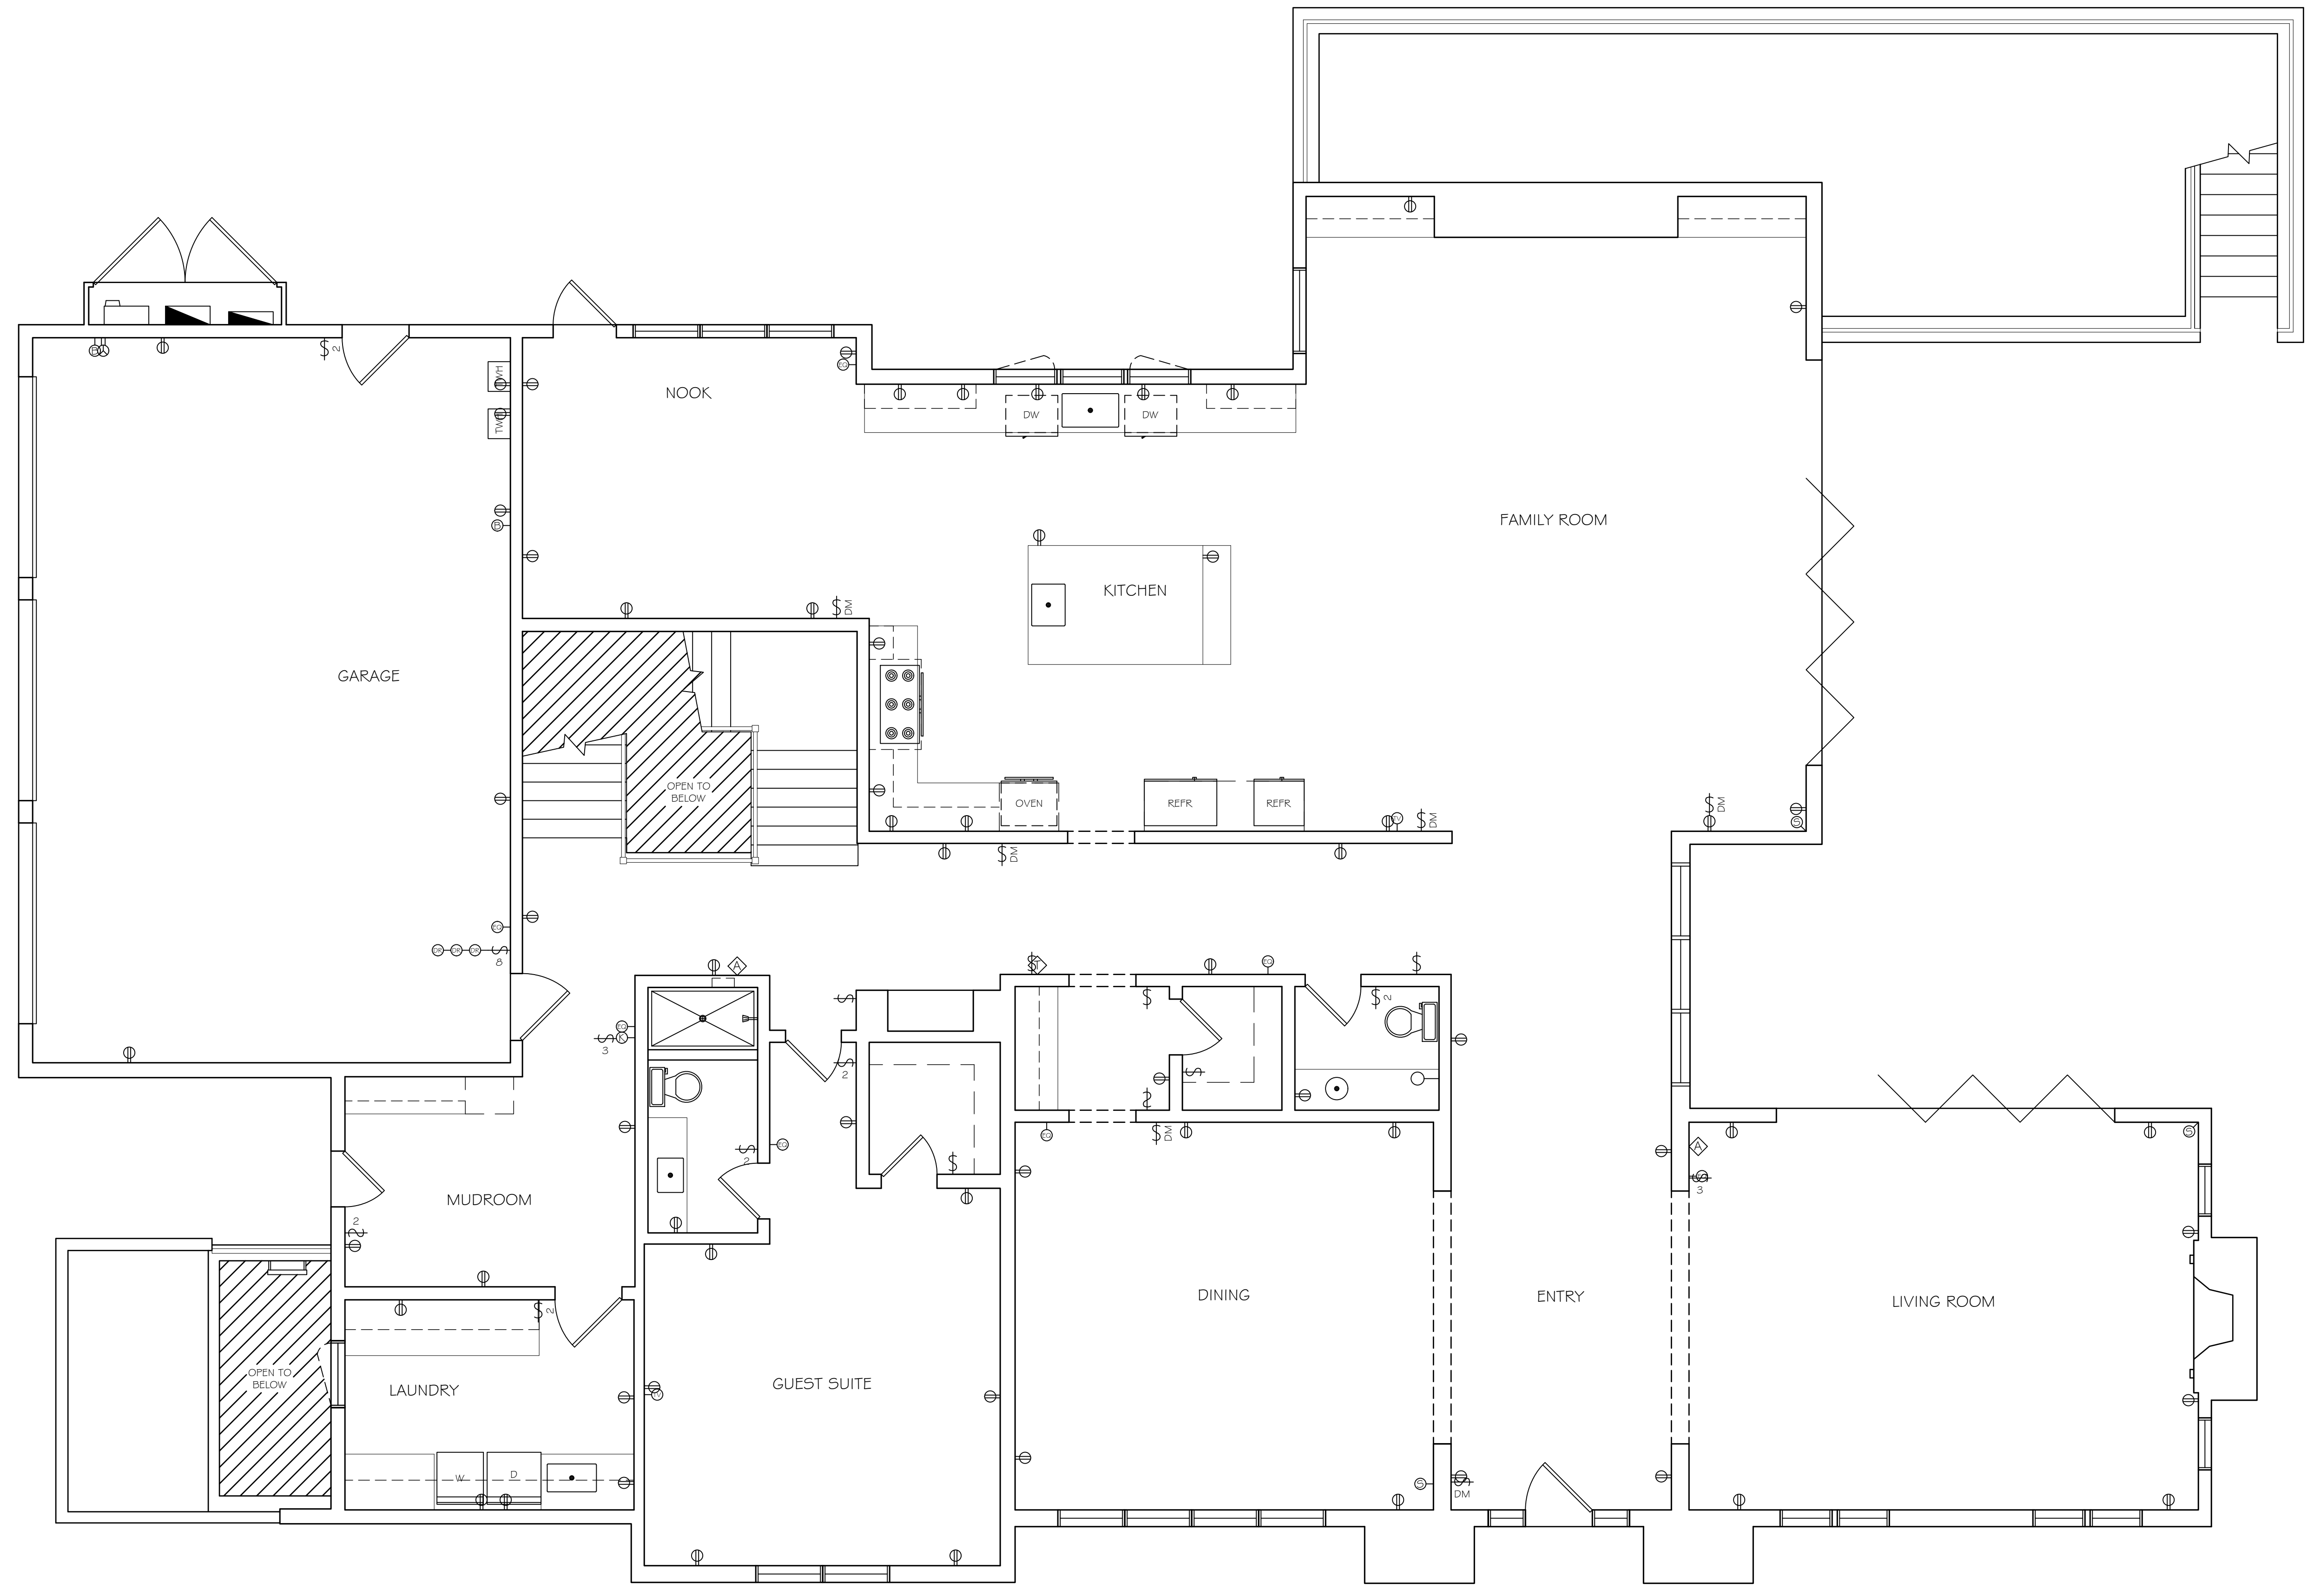

1st FLOOR

- ⚡ = SWITCH
- = SINGLE OUTLET
- ⊕ = DUPLEX OUTLET
- ⊕⊕ = QUADRUPLEX OUTLET
- ⊕⊕ = OUTLET-SWITCH COMBO
- ⊕ = 220V OUTLET
- ⊕ = FLOOR DUPLEX OUTLET
- ⊕ = FLOOR QUADRUPLEX OUTLET
- ⊕ = GFCI DUPLEX OUTLET
- ⊕ = SPECIAL PURPOSE OUTLET
- 📷 = WALL MOUNTED CAMERA
- ⊗ = WALL COVER PLATE
- ⊖ = THERMOSTAT
- 🔊 = WALL MOUNTED SPEAKER
- ⊏ = DISCONNECT SWITCH
- ⊏ = WALL MOUNTED FIXTURE
- ⊏ = WALL MOUNTED FLUORESCENT LIGHT
- ⊏ = FLUSH MOUNTED ELECTRICAL PANEL
- ⊏ = MOUNTED ELECTRICAL PANEL
- ⊏ = ELECTRIC METER
- 📞 = TELEPHONE JACK
- 📡 = DATA/INTERNET JACK
- 📺 = CABLE TV JACK
- ⊕ = MISC. EQUIPMENT
- ⊕ = BLANK
- ⊕ = AUDIO/VIDEO
- ⊕ = ROUTER
- ⊕ = SECURITY KEY PAD
- ⊕ = REMOTE DOOR RELEASE
- ⊕ = SENSOR
- ⊕ = CONDUIT
- ⊕ = J-BOX



PREPARED FOR

CLIENT

PROJECT TYPE

**ELECTRICAL PLAN**


PROJECT NAME

LARGE SFR  
SAMPLE

PROJECT ADDRESS

1234 PRECISION  
BOULEVARD  
CITY, CA 00000

All plans created by Precision Property Measurements, LLC ("PPM") are made exclusively for the purposes of the project and are not to be used for any other purpose. PPM does not warrant the accuracy or completeness of the information provided on these plans. PPM makes every reasonable effort to ensure the accuracy of the information provided on these plans. However, some errors may occur due to human error or other factors. PPM makes every reasonable effort to ensure the accuracy of the information provided on these plans. However, some errors may occur due to human error or other factors. PPM makes every reasonable effort to ensure the accuracy of the information provided on these plans. However, some errors may occur due to human error or other factors.

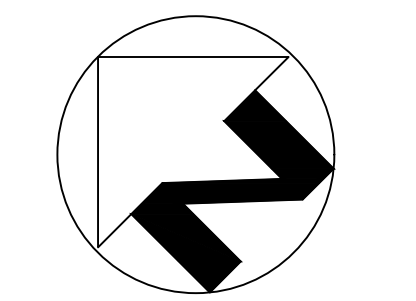



SCALE  
1/4" = 1'-0"

PROJECT  
XXXX\_XX

APPROVED BY  
XX

DATE  
XX/XX/XX

SHEET  
8 of 25

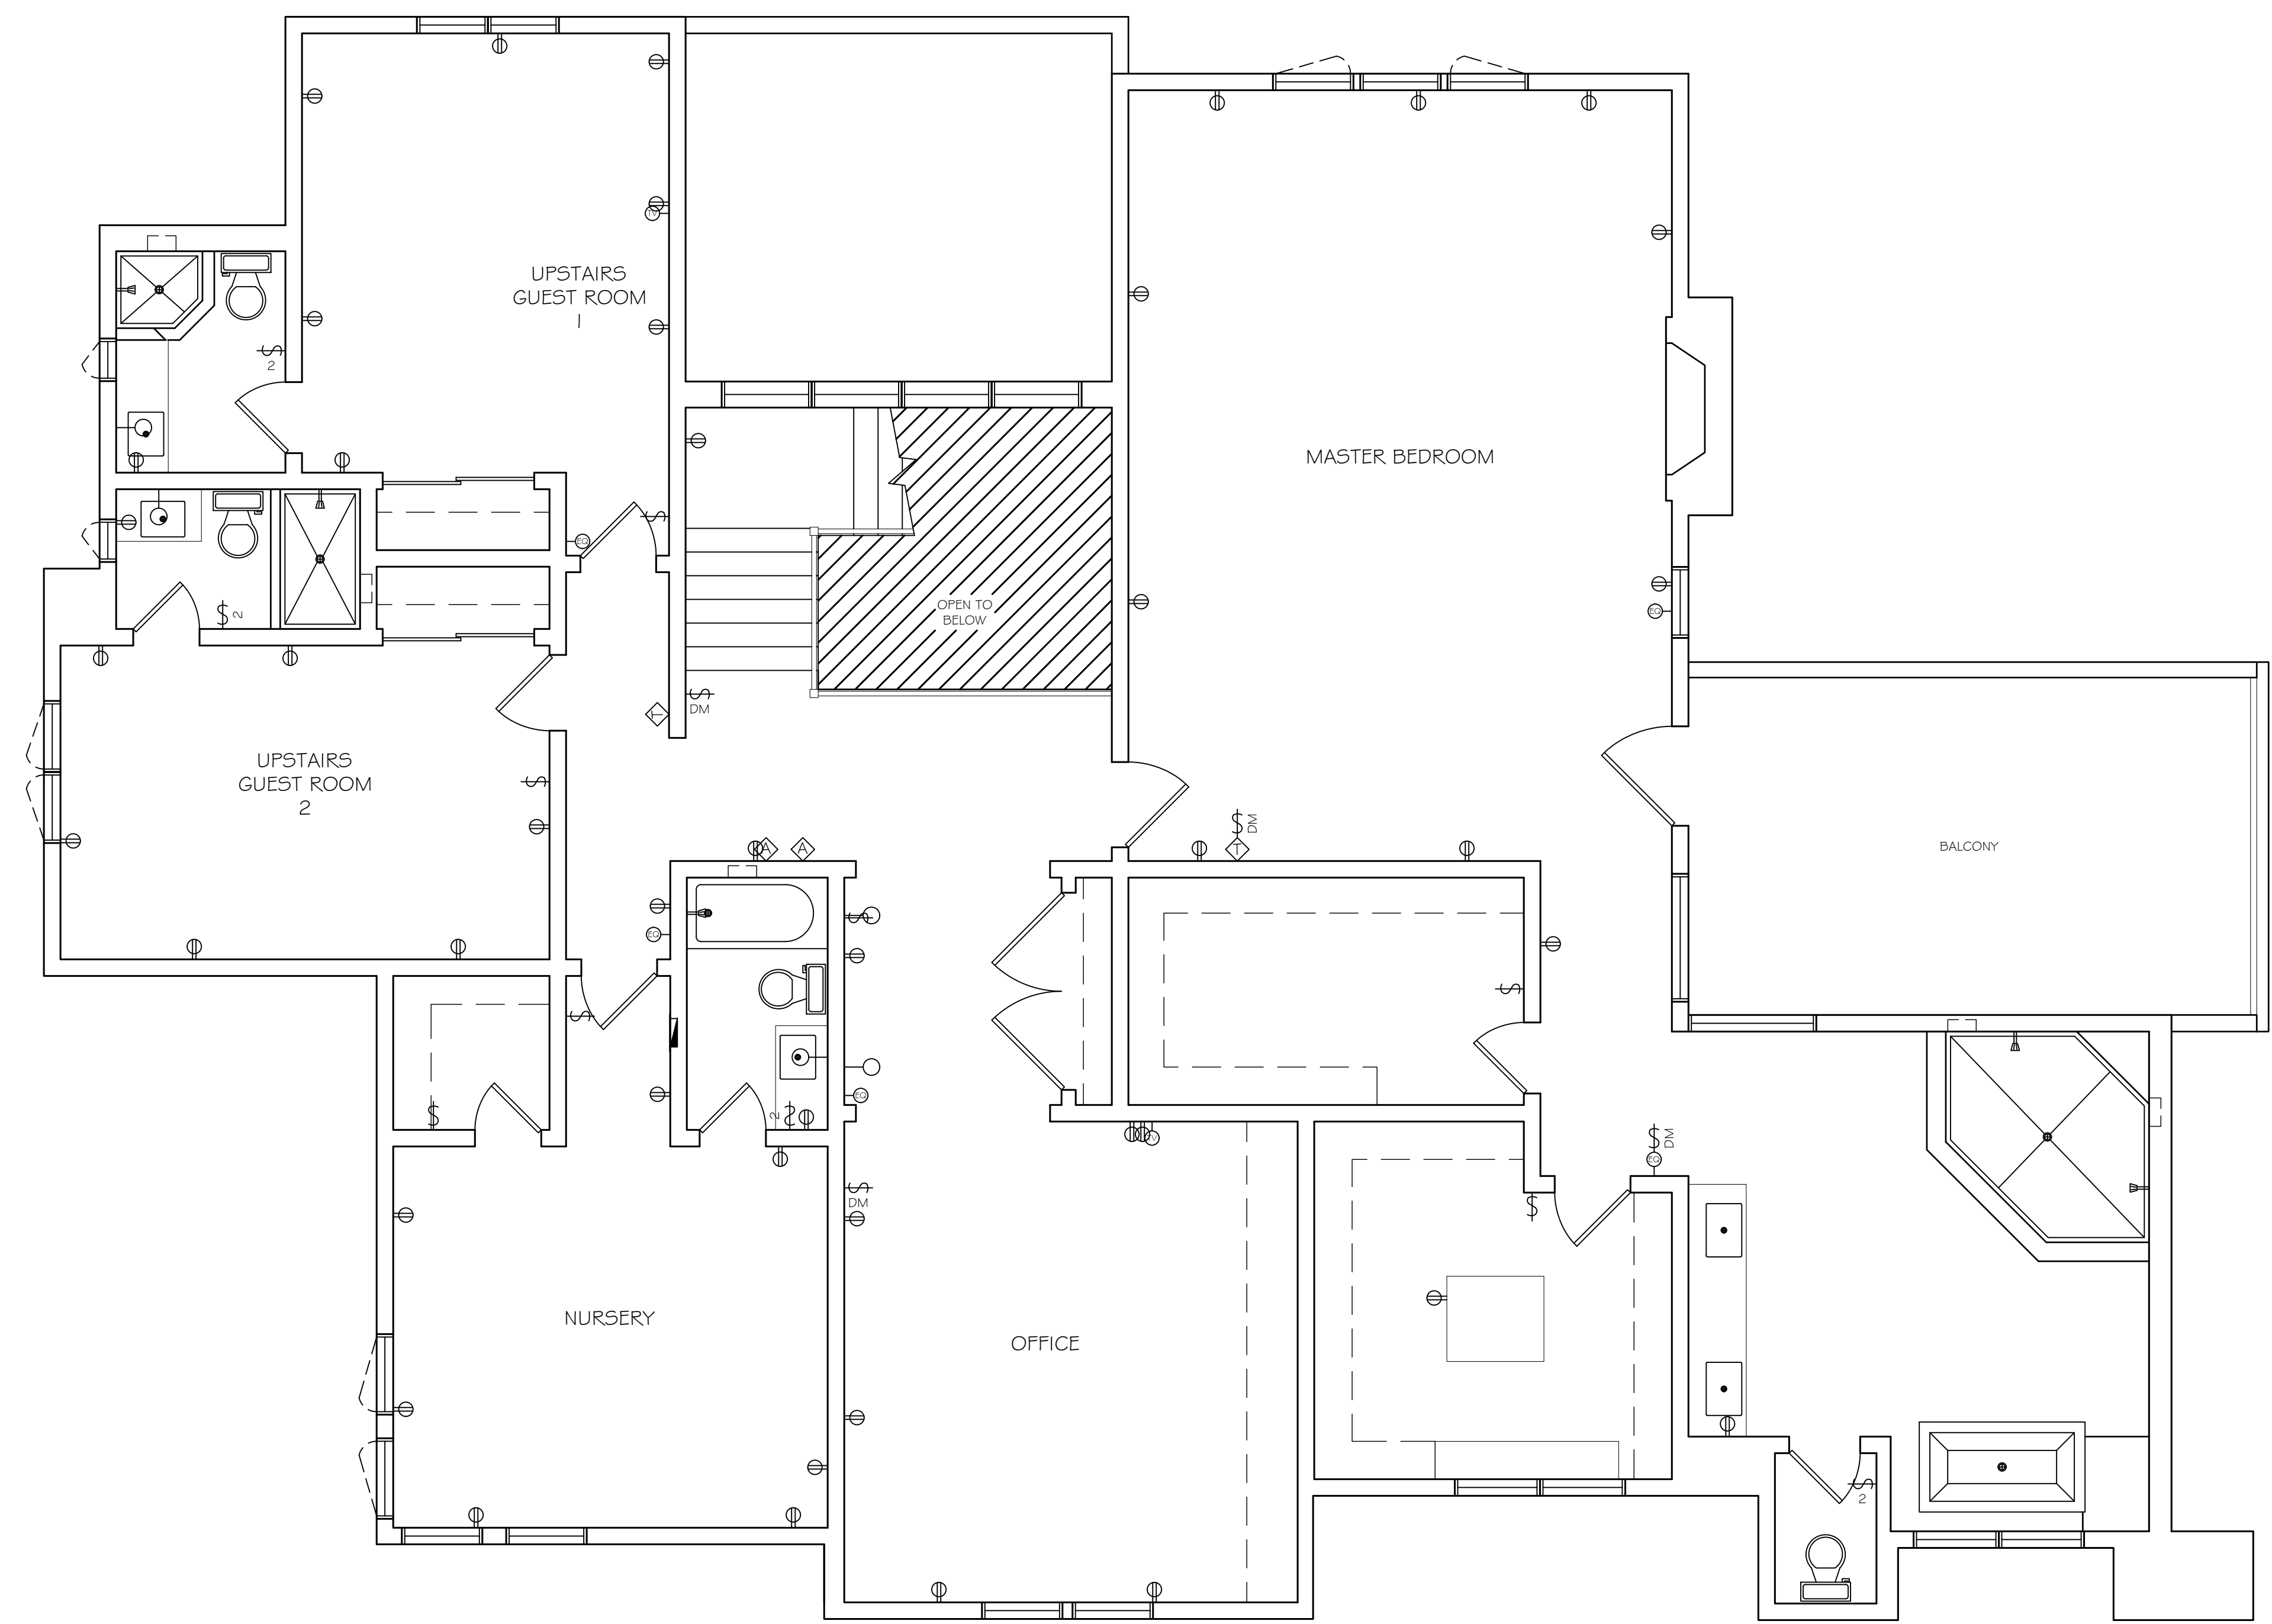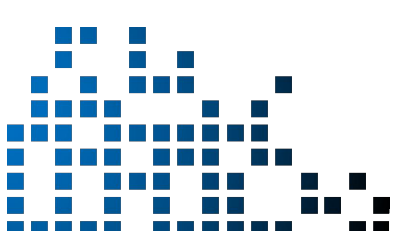

2nd FLOOR

- ⊕ = SWITCH
- = SINGLE OUTLET
- ⊖ = DUPLEX OUTLET
- ⊕⊖ = QUADRUPLUX OUTLET
- ⊕⊖ = OUTLET-SWITCH COMBO
- ⊖ = 220V OUTLET
- ⊖ = FLOOR DUPLEX OUTLET
- ⊖ = FLOOR QUADRUPLUX OUTLET
- ⊖ = GFCI DUPLEX OUTLET
- ⊖ = SPECIAL PURPOSE OUTLET
- ⊖ = WALL MOUNTED CAMERA
- ⊖ = WALL COVER PLATE
- ⊖ = THERMOSTAT
- ⊖ = WALL MOUNTED SPEAKER
- ⊖ = DISCONNECT SWITCH
- ⊖ = WALL MOUNTED FLUORESCENT LIGHT
- ⊖ = FLUSH MOUNTED ELECTRICAL PANEL
- ⊖ = MOUNTED ELECTRICAL PANEL
- ⊖ = ELECTRIC METER
- ⊖ = TELEPHONE JACK
- ⊖ = DATA/INTERNET JACK
- ⊖ = CABLE TV JACK
- ⊖ = MISC. EQUIPMENT
- ⊖ = BLANK
- ⊖ = AUDIO/VIDEO
- ⊖ = ROUTER
- ⊖ = SECURITY KEY PAD
- ⊖ = REMOTE DOOR RELEASE
- ⊖ = SENSOR
- ⊖ = CONDUIT
- ⊖ = J-BOX



PREPARED FOR

CLIENT

PROJECT TYPE

ELECTRICAL PLAN

PROJECT NAME

LARGE SFR SAMPLE

PROJECT ADDRESS

1234 PRECISION BOULEVARD CITY, CA 00000

All plans created by Precision Property Measurements use PPM's own field accuracy for landscaping purposes (i.e. this is not a full scale construction plan). PPM does not make the determination of any property line, and as such, does not constitute a survey.

All plans created by PPM are intended to be used as a reference for design and construction and should not be considered a substitute for the services of a licensed structural engineer or licensed architect. PPM makes every reasonable effort to ensure the accuracy of its information based on data provided to it.

All design elements contained herein are the design of the architect, contractor, designer or other licensed professional, and a consultant to the property owner. To determine the suitability of the As-Built plans prior to construction, Measurements should be field confirmed before commencing construction. In the event that an error is found on a plan, PPM's liability is limited to the amount of the fee paid to PPM.

SCALE

1/4" = 1'-0"

PROJECT

XXXX\_XX

APPROVED BY


XX

DATE

XX/XX/XX

SHEET

9 of 25

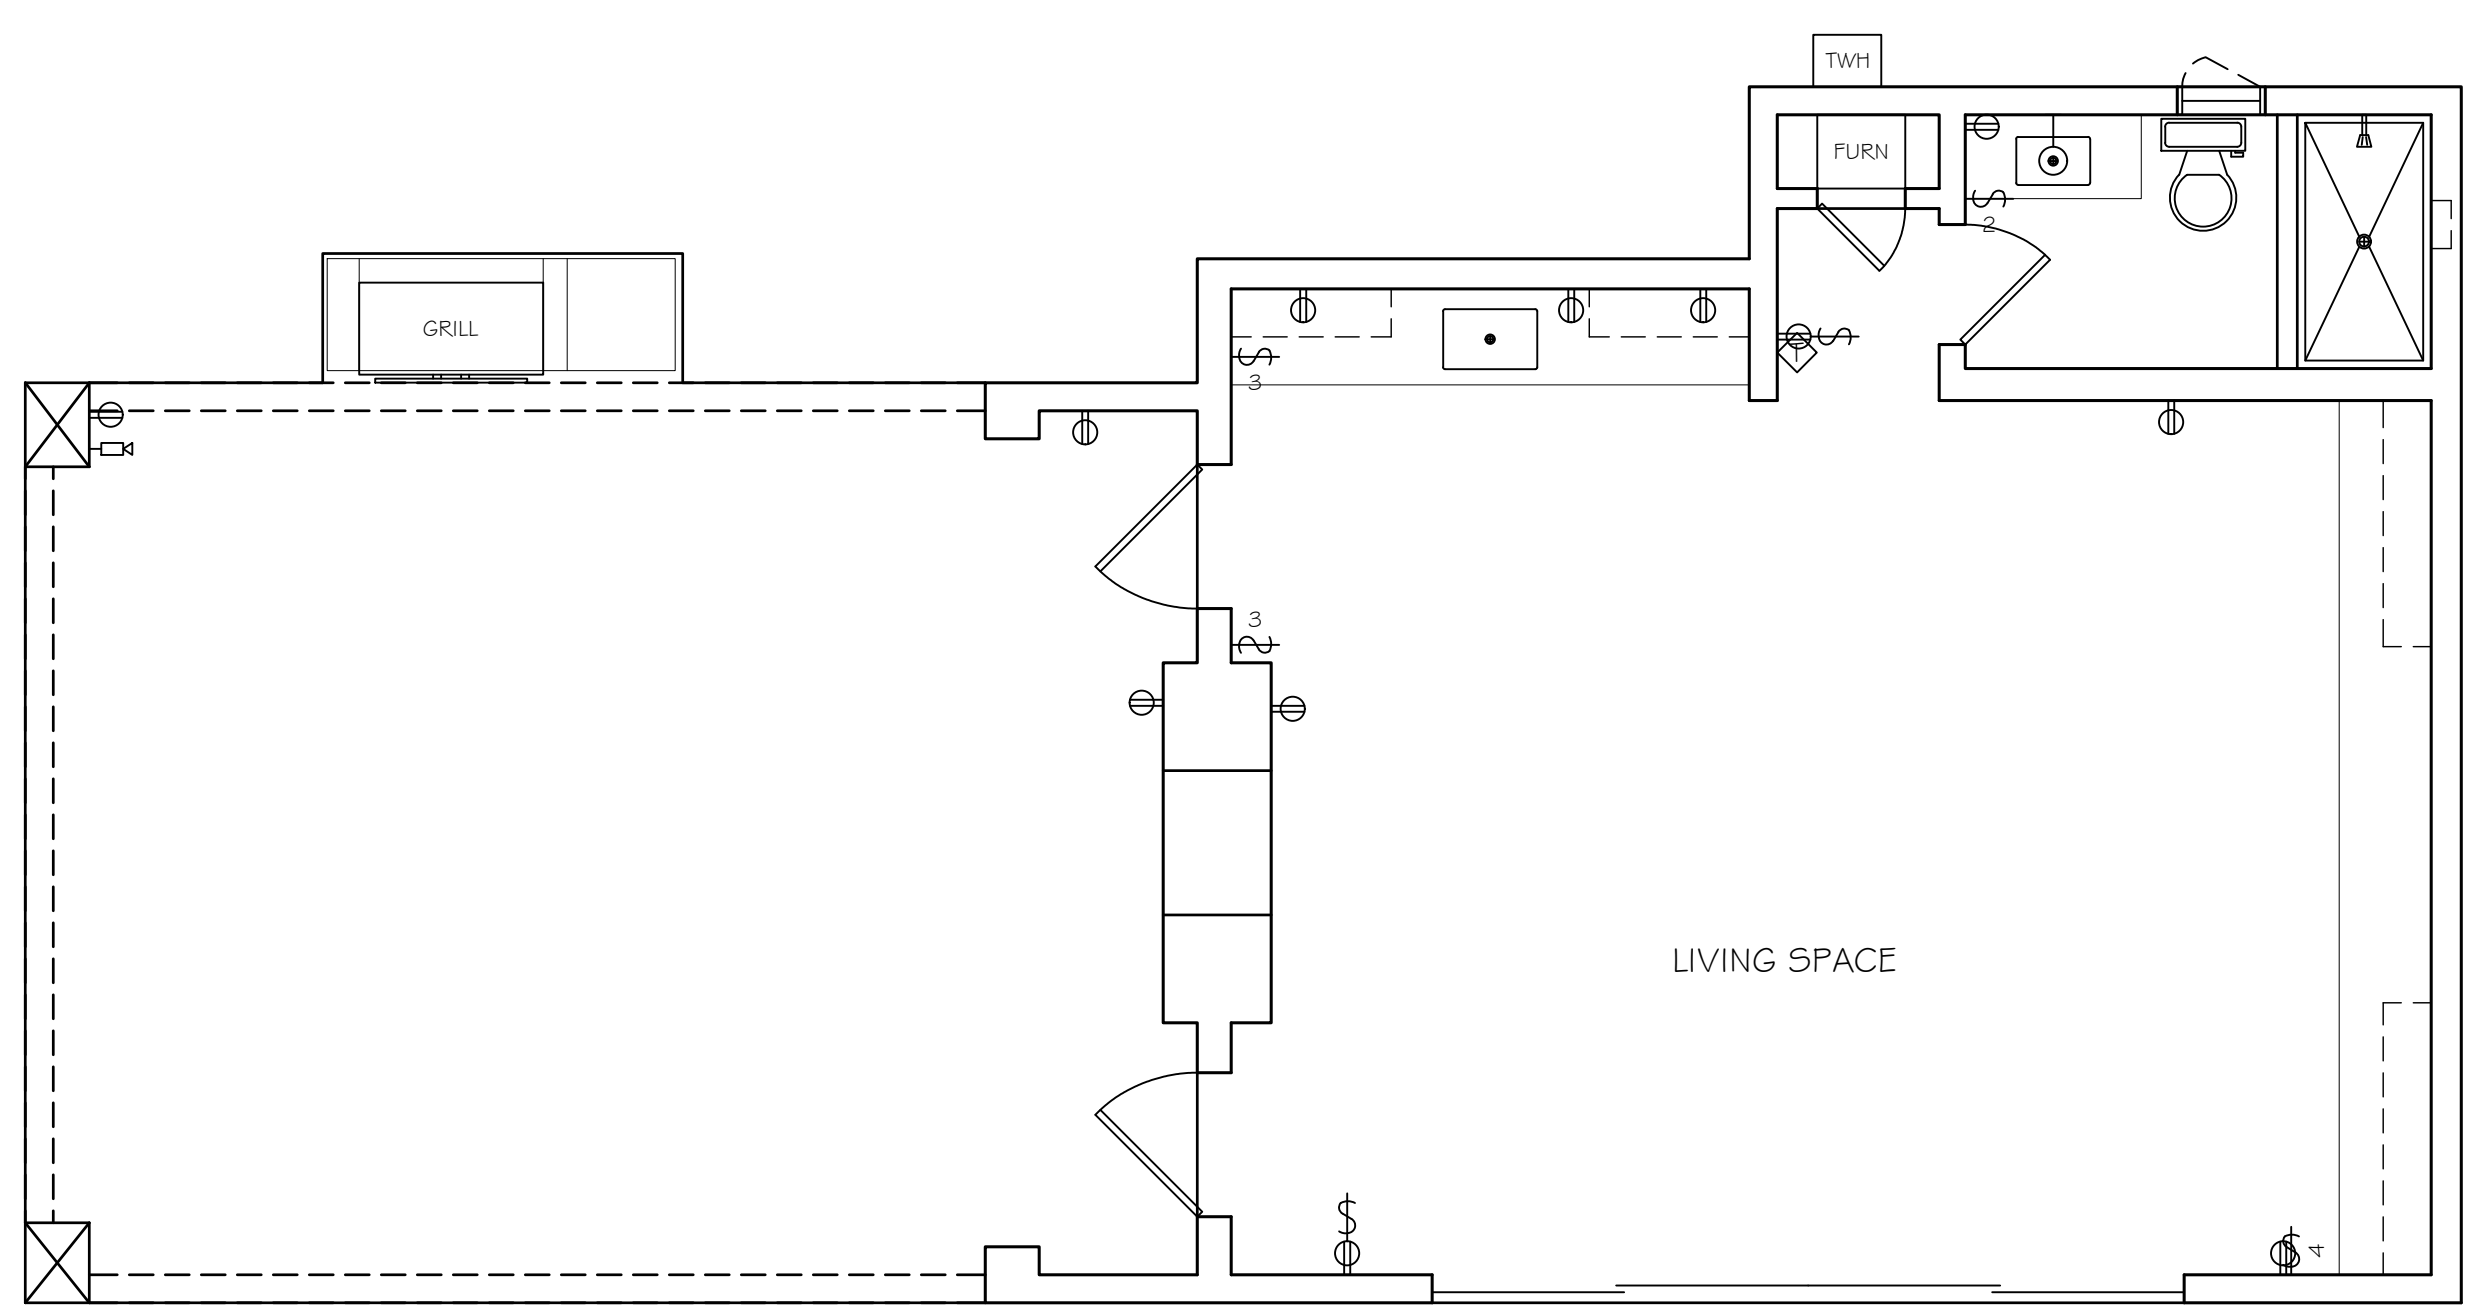

POOL HOUSE