

- LOW CASEWORK
- UPPER CASEWORK
- FULL HEIGHT CASEWORK
- WD = WASHER/DRYER COMBO
- W = WASHER
- D = DRYER
- RANGE
- REFR = REFRIGERATOR
- OVEN
- DW = DISH WASHER
- TC = TRASH COMPACTOR
- FURN = FURNACE
- 3 = WALL HEATER
- GM = GAS METER
- EM = ELECTRIC METER
- PCV = SOLAR COMPONENTS
- EP = ELECTRICAL PANEL
- TWH = TANKLESS WATER HEATER
- WH = WATER HEATER
- FD = FLOOR DRAIN
- CLG = CEILING HEIGHT
- HH = HEADER HEIGHT

3626 E. PACIFIC COAST  
HIGHWAY | 2ND FLOOR  
LONG BEACH CA | 90804  
T 562.621.9100  
F 888.698.2966  
WWW.PPMCO.NET



PREPARED FOR

CLIENT

PROJECT TYPE

FLOOR PLAN

PROJECT NAME

LARGE SFR  
SAMPLE

PROJECT ADDRESS

1234 PRECISION  
BOULEVARD  
CITY, CA 00000

All plans created by Precision Property Measurements, LLC (PPM) are made exclusively for the purposes of the project. PPM does not warrant the accuracy of the information provided on these plans. PPM makes every reasonable effort to ensure the accuracy of the information provided on these plans. However, PPM is not a structural engineer or licensed architect. PPM makes every reasonable effort to ensure the accuracy of the information provided on these plans. However, PPM is not a structural engineer or licensed architect. PPM makes every reasonable effort to ensure the accuracy of the information provided on these plans. However, PPM is not a structural engineer or licensed architect.


SCALE  
1/4" = 1'-0"

PROJECT  
XXXX\_XX

APPROVED BY  
XX

DATE  
XX/XX/XX

SHEET  
2 of 25

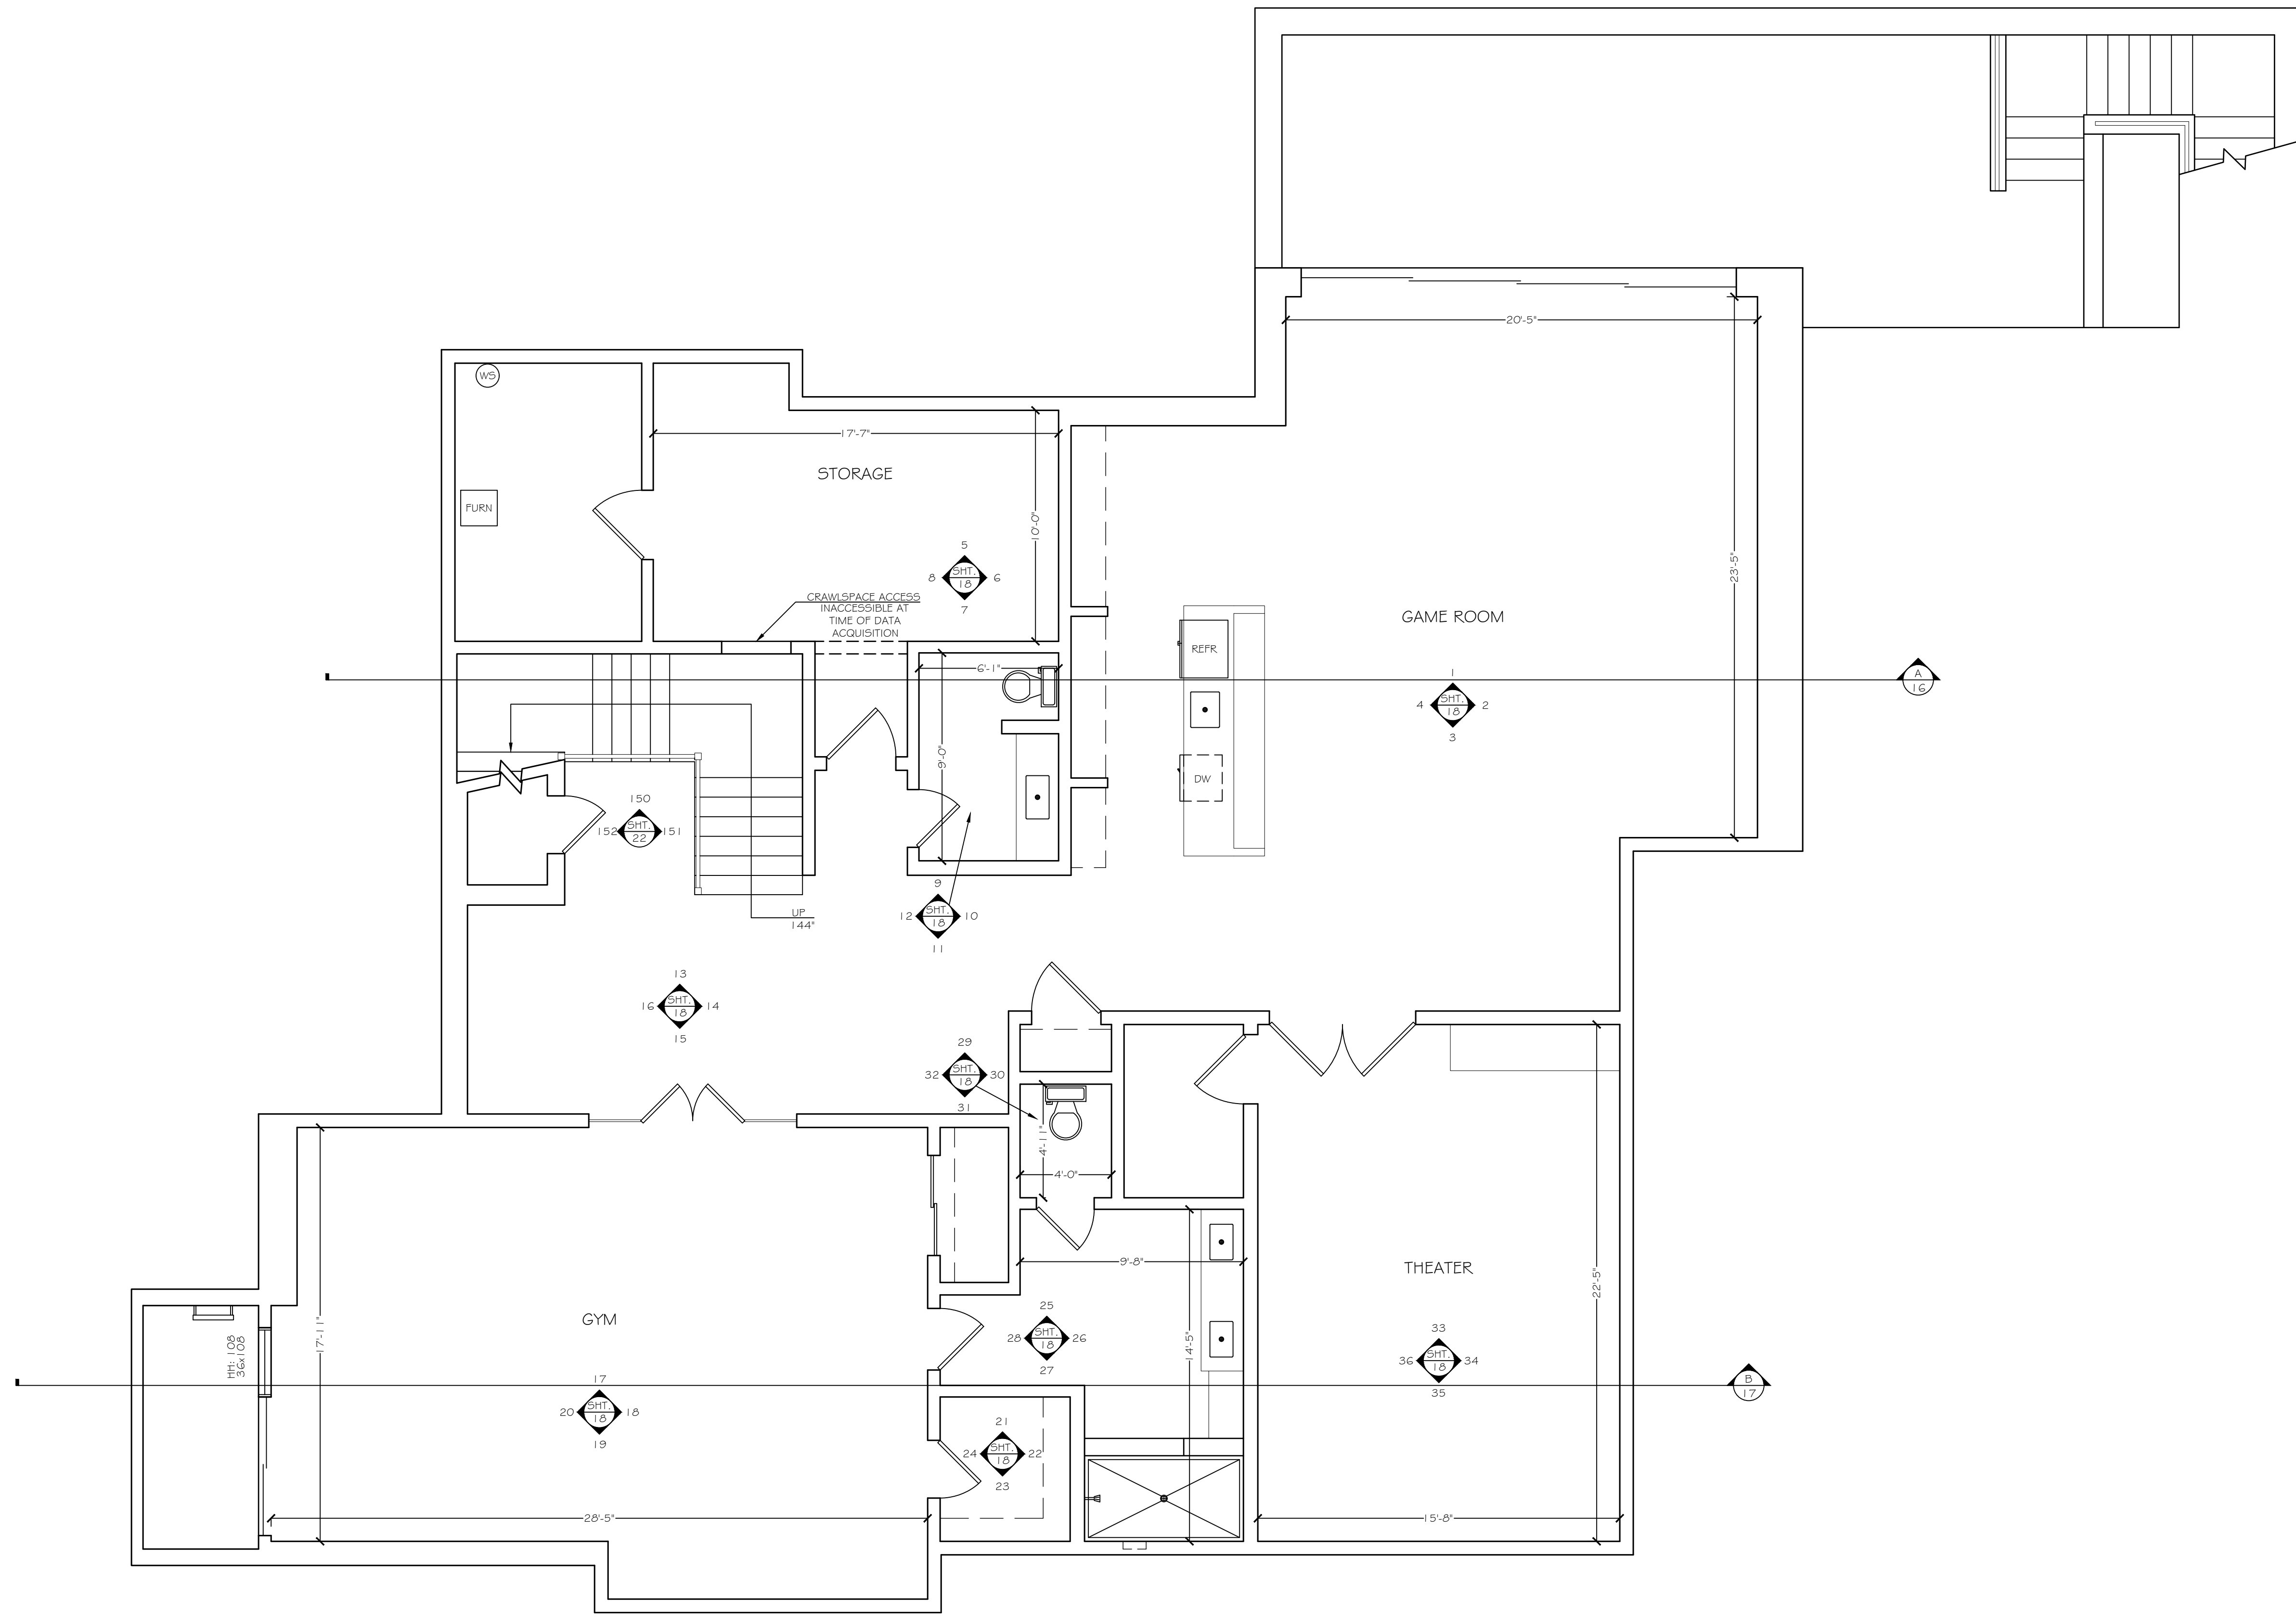

**BASEMENT**

- LOW CASEWORK
- UPPER CASEWORK
- FULL HEIGHT CASEWORK
- WD = WASHER/DRYER COMBO
- W = WASHER
- D = DRYER
- RANGE
- REFR = REFRIGERATOR
- OVEN
- DW = DISH WASHER
- TC = TRASH COMPACTOR
- FURN = FURNACE
- WALL HEATER
- GAS METER
- ELECTRIC METER
- PCV = SOLAR COMPONENTS
- ELECTRICAL PANEL
- TWH = TANKLESS WATER HEATER
- WH = WATER HEATER
- FLOOR DRAIN
- CLG = CEILING HEIGHT
- HH = HEADER HEIGHT



PREPARED FOR

CLIENT

PROJECT TYPE

FLOOR PLAN


PROJECT NAME

LARGE SFR SAMPLE

PROJECT ADDRESS

1234 PRECISION BOULEVARD  
 CITY, CA 00000

All plans created by Precision Property Measurements. Use of PPM is made exclusively for landscaping purposes. See the PPM Code 88727. All data plans created by PPM do not include the determination of any property line, and as such do not constitute a subdivision. See the PPM Code 88727. In addition, PPM services and plans do not constitute an engineering or architectural service, and this should not be used for any studies or activities defined as such engineering (See the PPM Code 88727). All floor plans created by PPM are intended to be used as a reference for design and construction and should not be considered a substitute for the services of a licensed structural engineer or licensed architect. PPM makes every reasonable effort to ensure the accuracy of the information located on our plans. However, some of our drawings represent conditions as they exist on the day of the architect, contractor, designer or other licensed professional, and a consultant to the property owner, to determine the suitability of the As-Built plans prior to construction. Measurements should be field confirmed before commencing construction, in the event that an error is found on a plan, PPM's liability is limited to the amount of the fee paid to PPM.

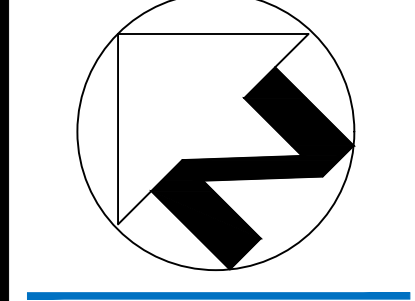


SCALE  
 1/4" = 1'-0"

PROJECT  
 XXXX\_XX

APPROVED BY  
 XX

DATE  
 XXX/XX/XX

SHEET  
 3 of 25


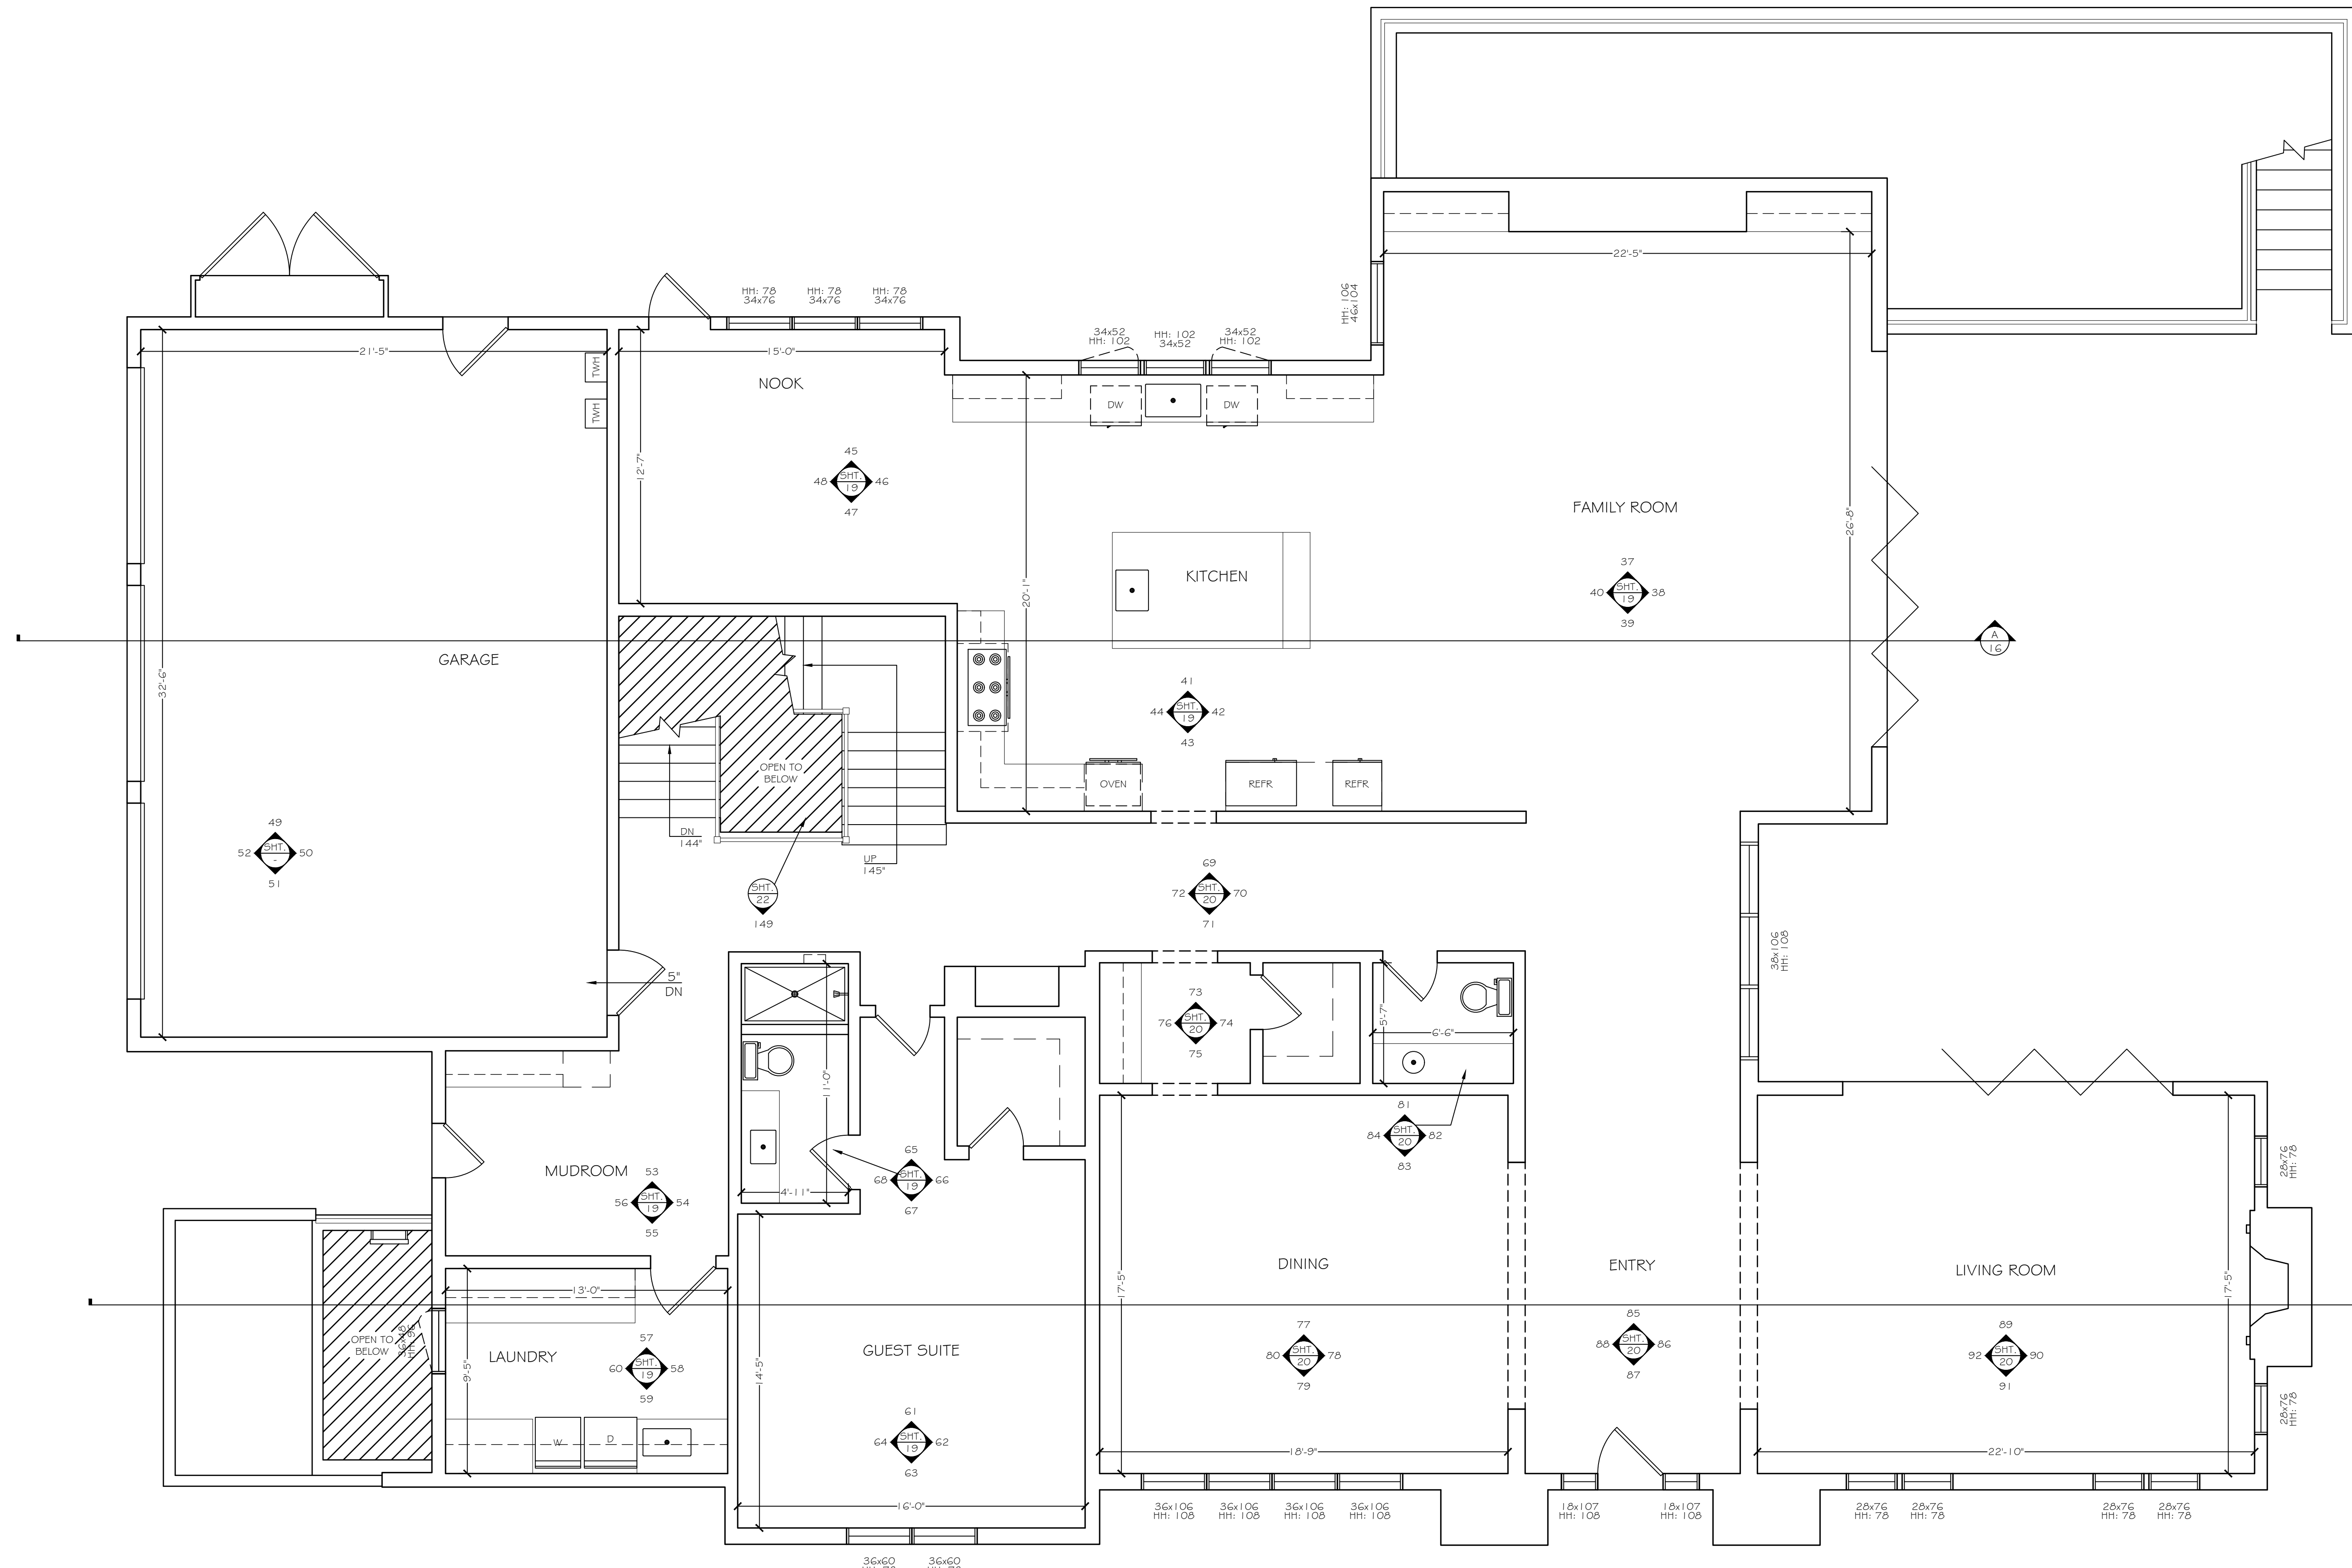


1st FLOOR


- LOW CASEWORK
- UPPER CASEWORK
- FULL HEIGHT CASEWORK
- WD = WASHER/DRYER COMBO
- W = WASHER
- D = DRYER
- RANGE
- REFR = REFRIGERATOR
- OVEN
- DW = DISH WASHER
- TC = TRASH COMPACTOR
- FURN = FURNACE
- WALL HEATER
- GAS METER
- ELECTRIC METER
- SOLAR COMPONENTS
- ELECTRICAL PANEL
- TANKLESS WATER HEATER
- WATER HEATER
- FLOOR DRAIN
- CEILING HEIGHT
- HEADER HEIGHT




All plans created by Precision Property Measurements, LLC ("PPM") are made exclusively for the purposes of the project and are not to be used for any other purpose. PPM does not warrant the accuracy of the information provided on these plans. PPM makes every reasonable effort to ensure the accuracy of the information provided on these plans. However, some of the information provided on these plans may be based on information provided to PPM by others. PPM is not responsible for any errors or omissions in the information provided on these plans. PPM's liability is limited to the amount of the fee paid to PPM.

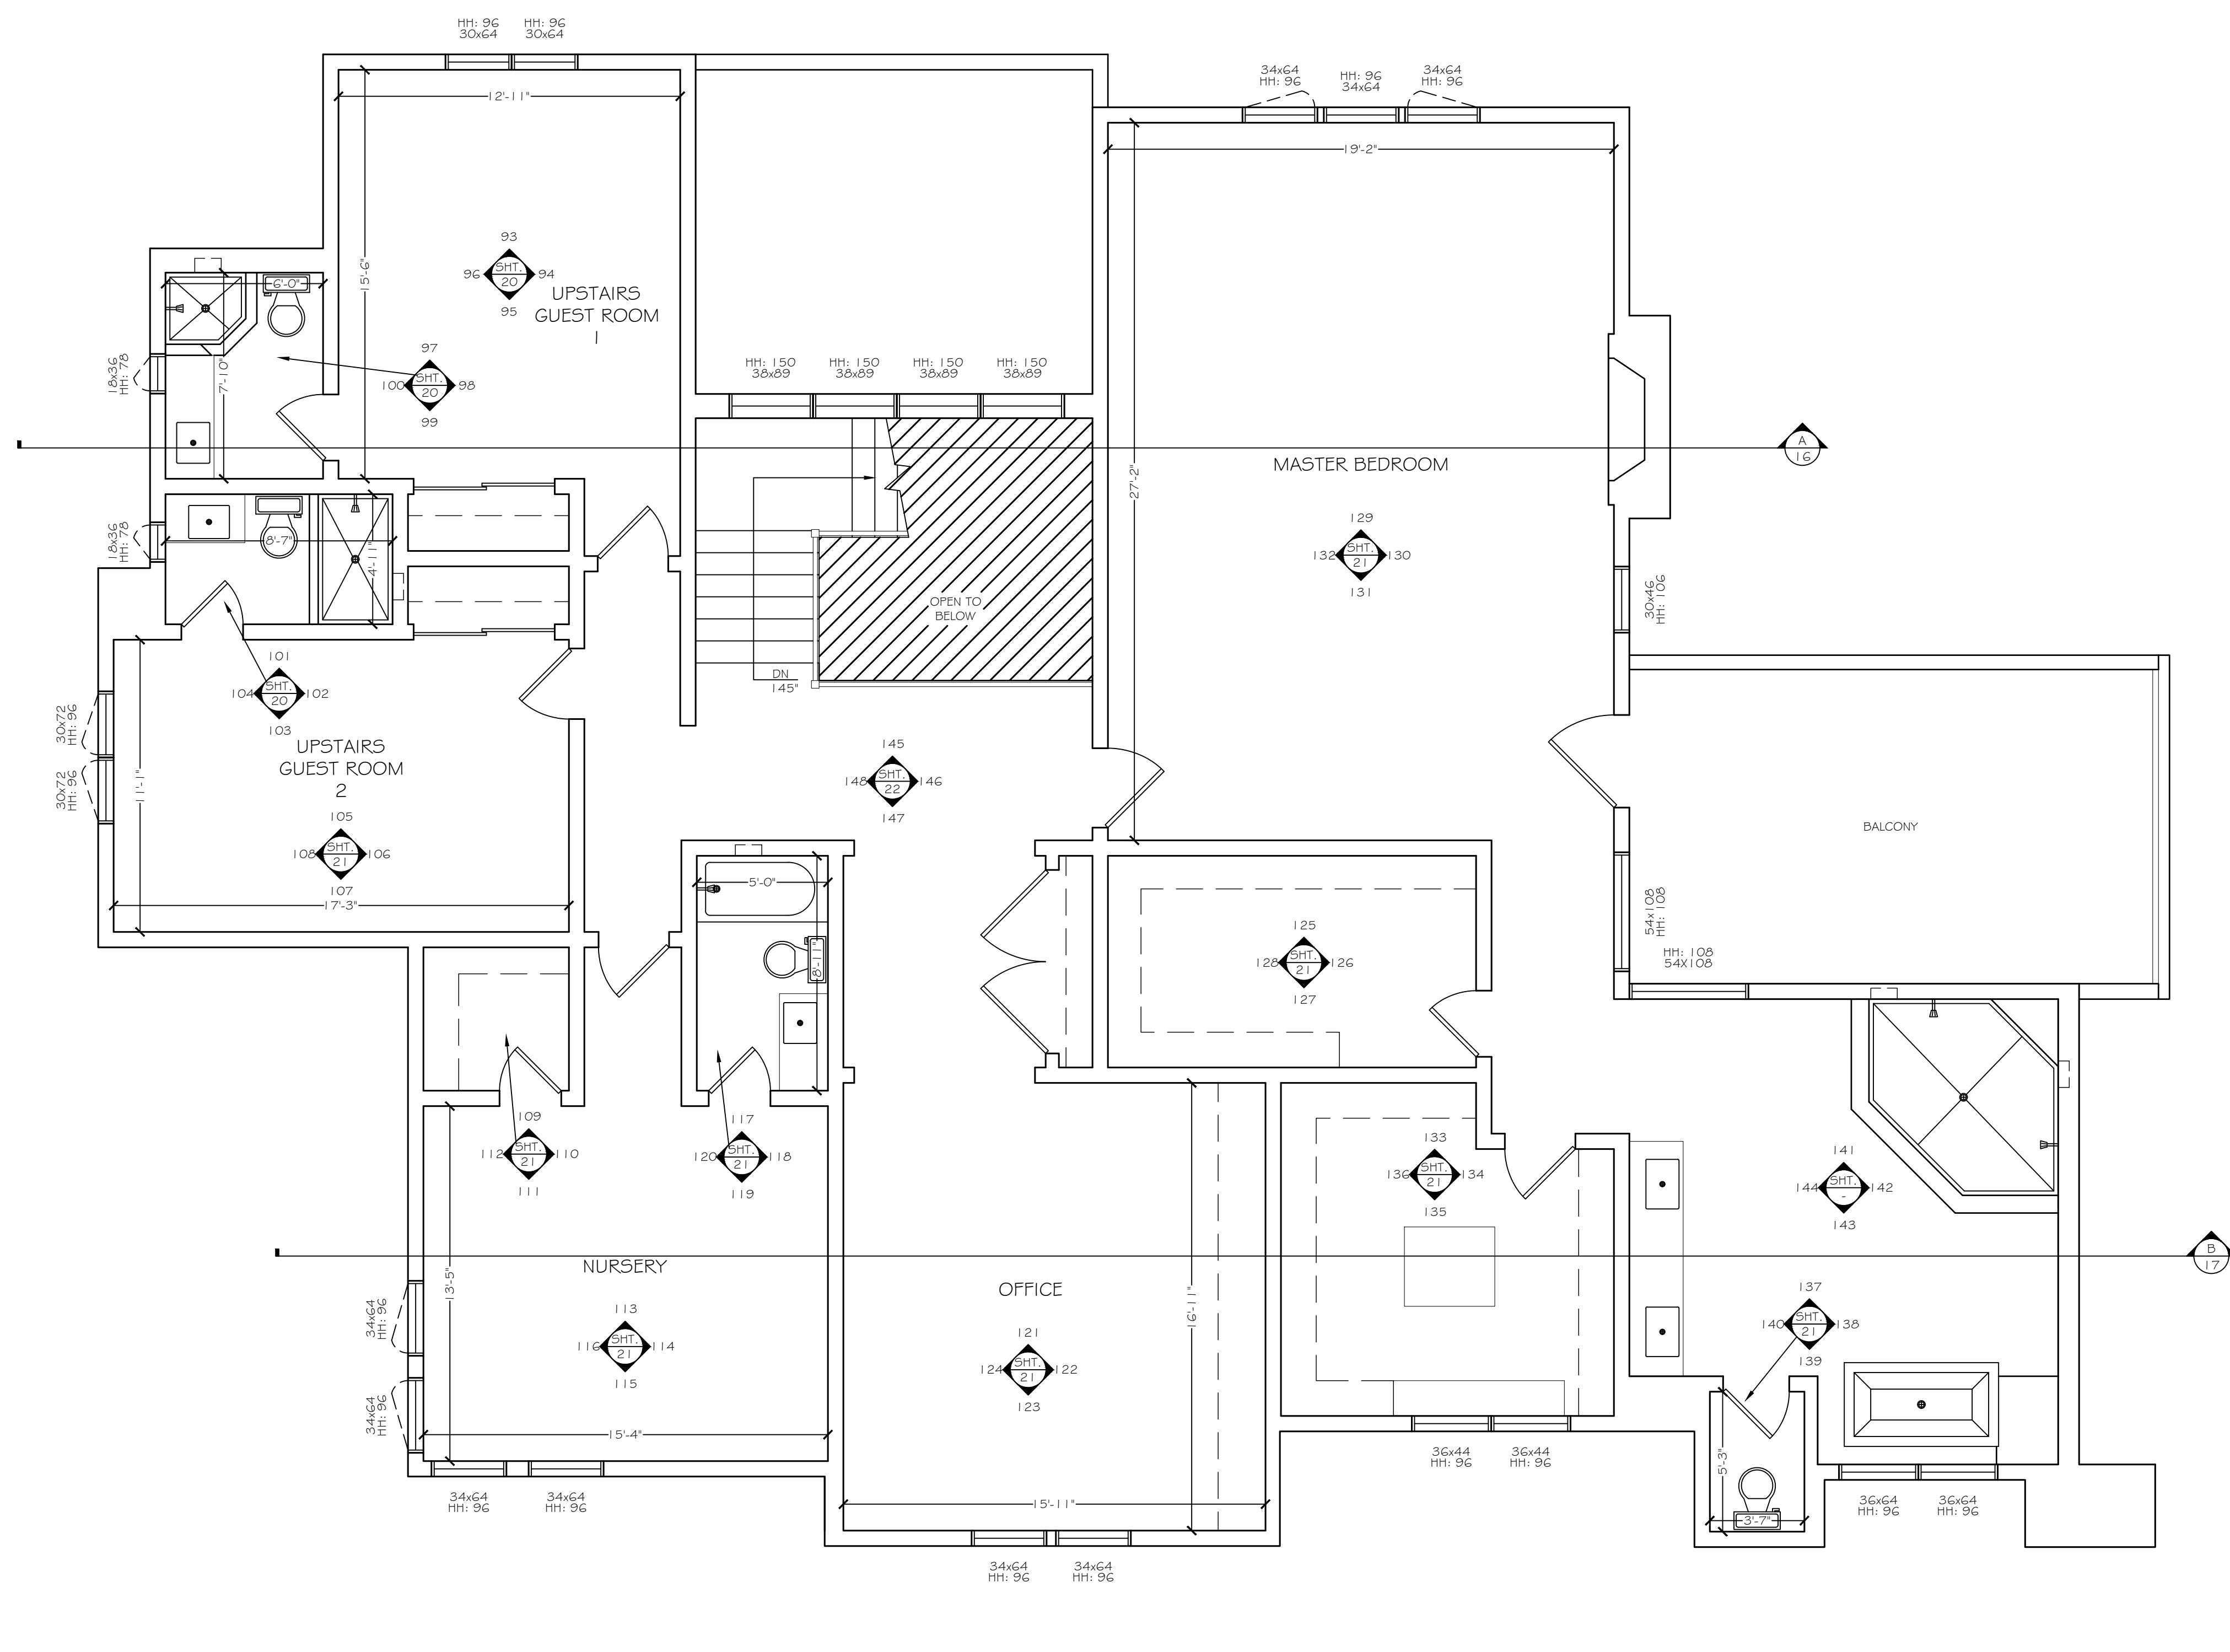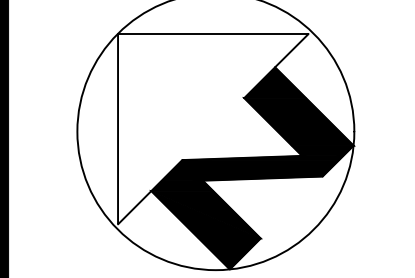

2nd FLOOR

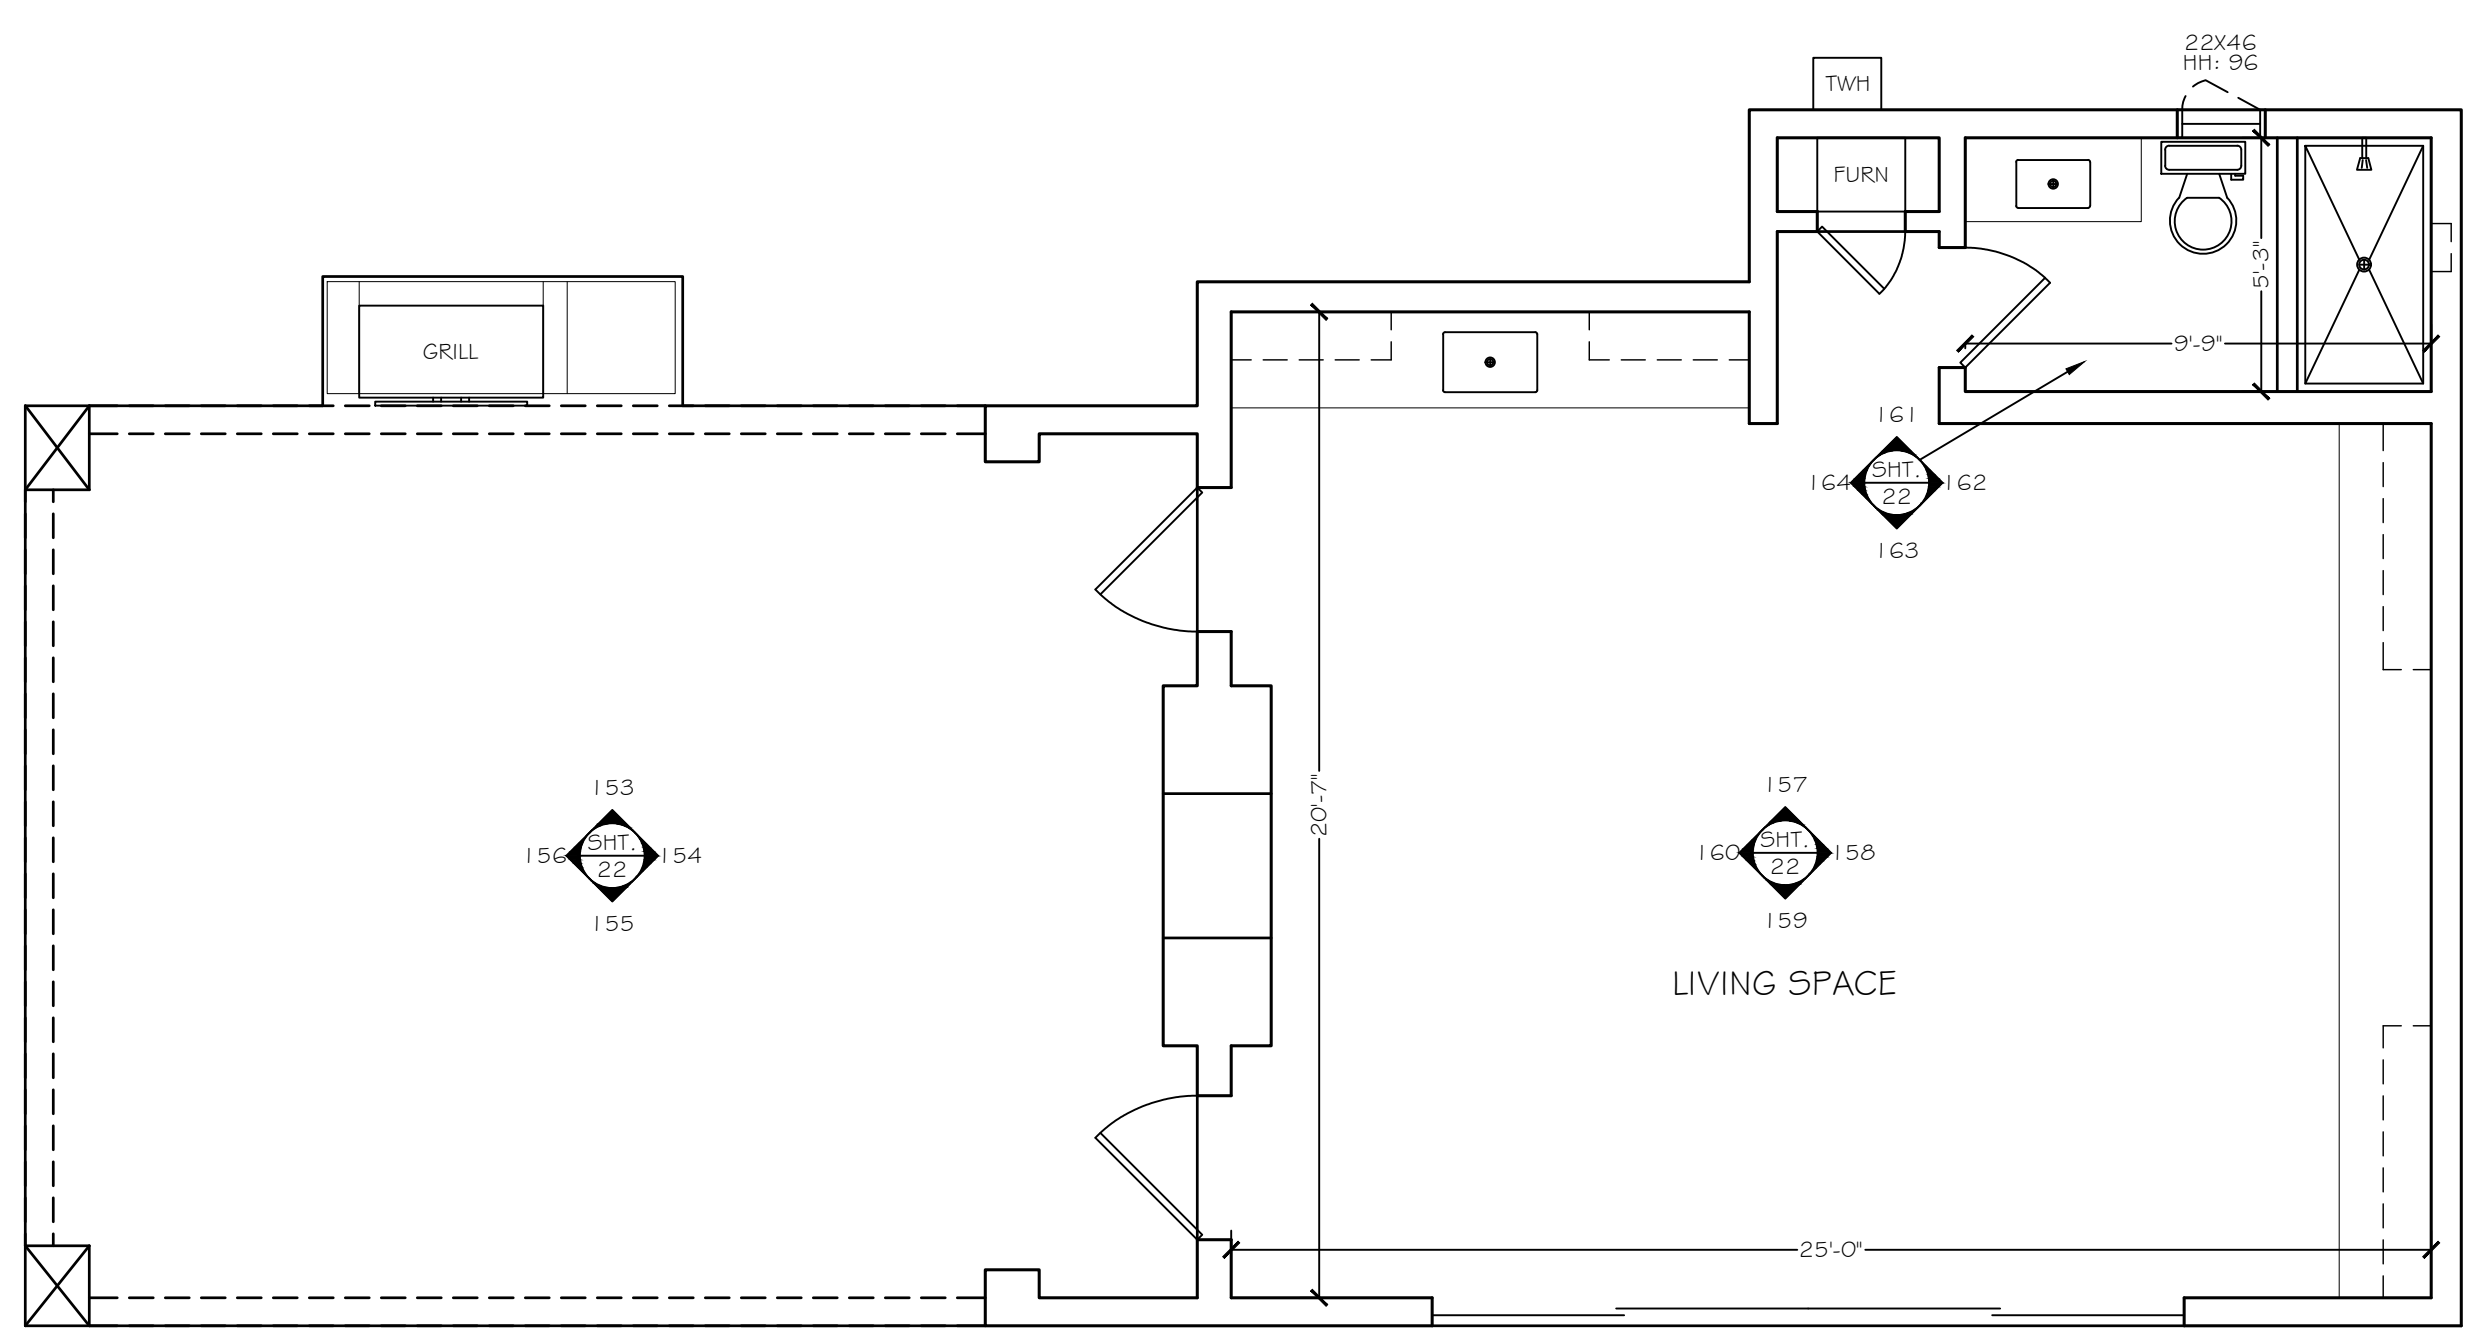

POOL HOUSE

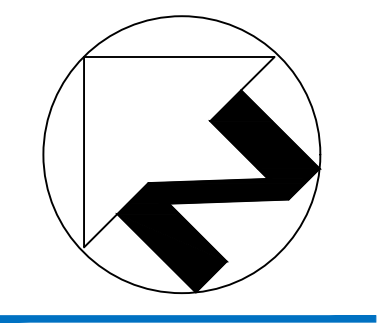

SCALE 1/4" = 1'-0"

PROJECT XXXX\_XX

APPROVED BY XX

DATE XX/XX/XX

SHEET 5 of 25

