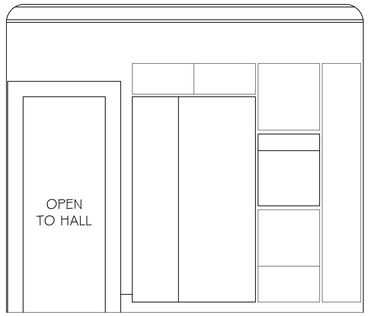

A KITCHEN

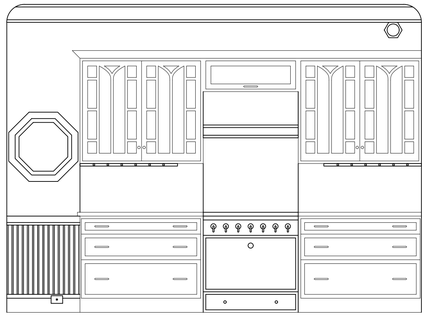

B KITCHEN

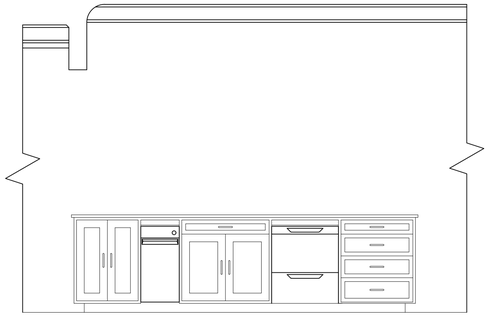

C KITCHEN ISLAND

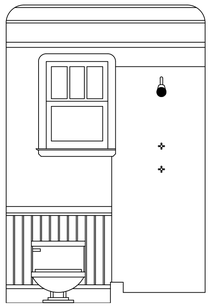

D BATHROOM

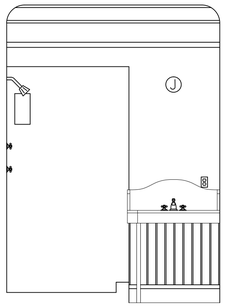

E BATHROOM

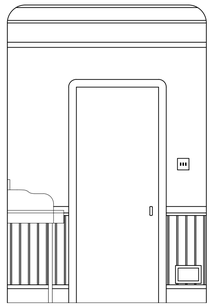

F BATHROOM

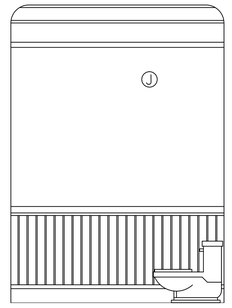

G BATHROOM

PPM
PRECISION PROPERTY MEASUREMENTS
3626 E. PACIFIC COAST HIGHWAY | 2ND FLOOR
LONG BEACH CA | 90804
T 562.621.9100
F 888.698.2966
WWW.PPMCO.NET

WORRY FREE RENOVATIONS

PREPARED FOR

ARCHITECT
PLANNING

PROJECT TYPE

INTERIOR
ELEVATIONS

PROJECT NAME

SMITH
RESIDENCE

PROJECT ADDRESS

1234 CHERRY TREE
BOULEVARD
LONG BEACH, CA 90000

All plans created by Precision Property Measurement Ltd "PPM" are made exclusively for the benefit of the owner (Cal. Bus. & Prof. Code §5726). All site plans created by PPM are not marine determinations of property lines, and as such do not constitute land surveying (Cal. Bus. & Prof. Code §§8726-8727). In addition, PPM services and plans do not constitute civil engineering (Cal. Bus. & Prof. Code §§6702-6704), and should not be relied upon for any purposes defined as civil engineering (Cal. Bus. & Prof. Code §6731). All floor plans created by PPM are intended to be used as a reference for design and construction and should not be considered a substitute for the services of a licensed structural engineer or licensed architect. PPM makes every reasonable effort to ensure the accuracy of the dimensions shown on our plans. However, the As-Built drawings may contain errors, omissions, or inconsistencies. It is the duty of the architect, contractor, designer or other licensed professional, as a consultant to the property owner, to determine the suitability of the As-Built plans prior to construction. Measurements should be field confirmed before commencing construction. n the event that an error is found in a plan, PPM's liability is limited to the amount of the fee paid to PPM.

SCALE
NO SCALE

PROJECT
12345

APPROVED BY
CT

DATE
9/18/19

SHEET
1 of 1