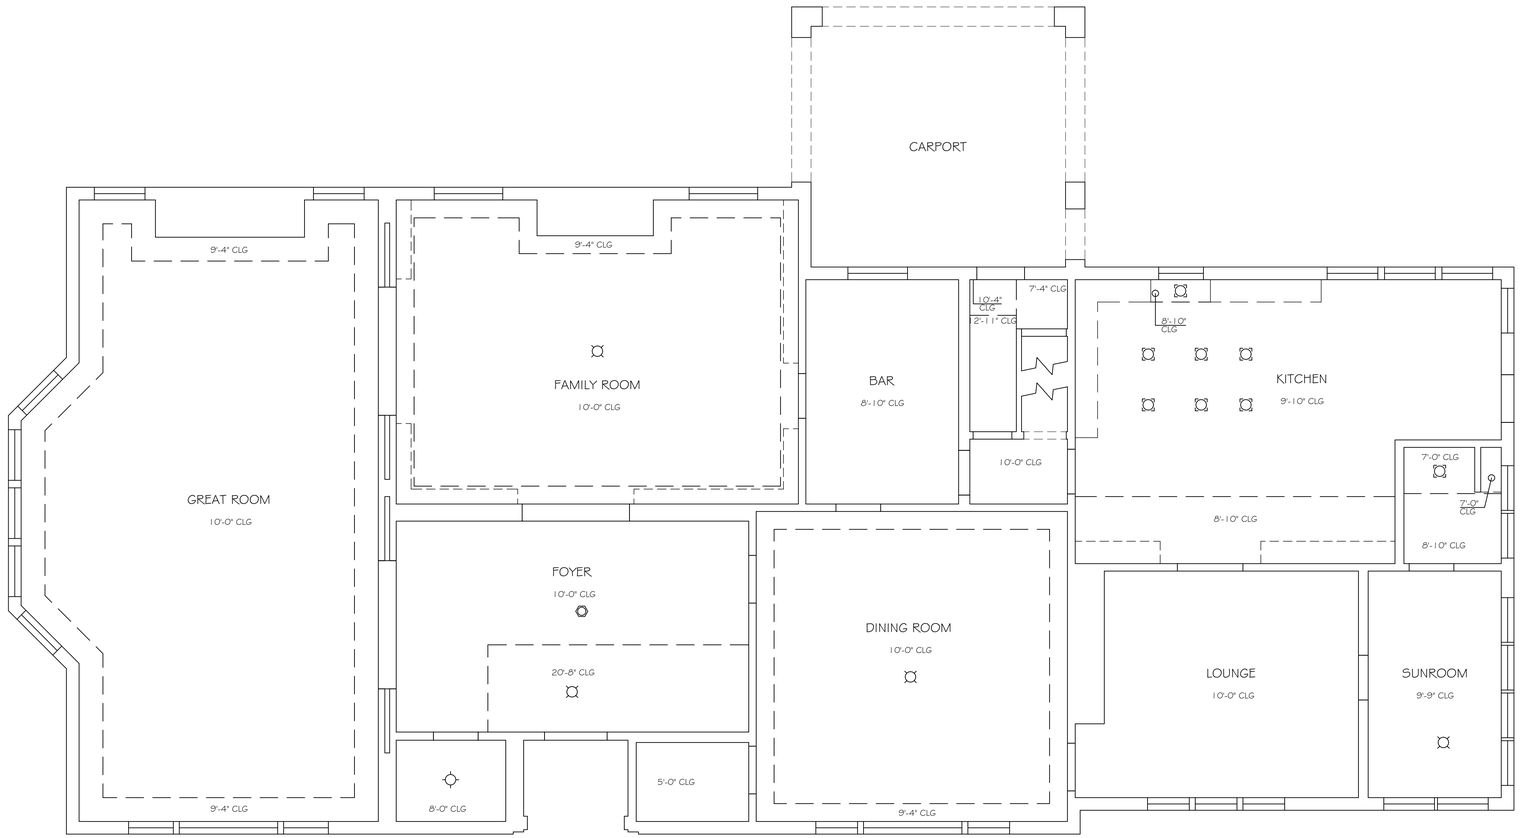

LEGEND

SOFFIT

- = CEILING DUPLEX
- = CEILING QUADRUPLEX
- = SPEAKER
- = SQUARE SPEAKER
- = EXHAUST FAN w/o LIGHT
- = EXHAUST FAN w/ LIGHT
- = CEILING FAN w/o LIGHT
- = CEILING FAN w/ LIGHT
- = FLUORESCENT LIGHTING
- = TRACK LIGHTING
- = CEILING-MOUNTED FIXTURE
- = RECESSED FIXTURE
- = HANGING FIXTURE
- = WALL MOUNTED FIXTURE
- = EXTERIOR WALL LIGHT
- = CEILING JUNCTION BOX
- = MOTION DETECTOR
- = MOTION DETECTOR
- = DOME SECURITY CAMERA
- = CEILING MOUNT CAMERA
- = COVER PLATE
- = SUPPLY VENT
- = RETURN VENT
- = ROUND SUPPLY VENT
- = EQUALIZER GRILLE
- = ROOF HATCH
- = SMOKE ALARM
- = EXIT SIGN
- = EMERGENCY LIGHT w/ EXIT
- = EMERGENCY LIGHT
- = SPRINKLER
- = HEAT DETECTOR

PPM
PRECISION PROPERTY MEASUREMENTS
3626 E. PACIFIC COAST HIGHWAY | 2ND FLOOR
LONG BEACH CA | 90804
T 562.621.9100
F 888.698.2966
WWW.PPMCO.NET

WORRY FREE RENOVATIONS

PREPARED FOR

ARCHITECT PLANNING

PROJECT TYPE

REFLECTED CEILING PLAN

PROJECT NAME

SMITH RESIDENCE

PROJECT ADDRESS

1234 CHERRY TREE BOULEVARD
LONG BEACH CITYSCAPE, CA 90000

All plans created by Precision Property Measurement Ltd "PPM" are made exclusively for landscaping purposes (Cal. Bus. & Prof. Code §8727). All site plans created by PPM do not involve the determination of any property line, and as such do not constitute land surveying (Cal. Bus. & Prof. Code §8726-8727). In addition, PPM services and plans do not constitute civil engineering (Cal. Bus. & Prof. Code §6700-6704), and thus should not be used for any studies or activities defined as civil engineering (Cal. Bus. & Prof. Code §6731). All floor plans created by PPM are intended to be used as a reference for design and construction and should not be considered a substitute for the services of a licensed structural engineer or licensed architect. PPM makes every reasonable effort to ensure the accuracy of the information found in our plans. However, every As-Built drawing inherently contains errors to some degree. It is the duty of the architect, contractor, designer or other licensed professional, as a consultant to the property owner, to determine the suitability of the As-Built plans prior to construction. Measurements should be field confirmed before commencing construction. In the event that an error is found on a plan, PPM's liability is limited to the amount of the fee paid to PPM.

N

SCALE
1/4" = 1'-0"

PROJECT
12345

APPROVED BY
CT

DATE
9/18/19

SHEET
10 of 17